

Stone
 @ 25,
 10-3-69

MISSISSIPPI
 BOARD OF WATER COMMISSIONERS
 416 North State Street
 Jackson, Mississippi 39201

CODED
 CODED
 CODED

WATER WELL DRILLERS LOG

10-3-1969 date well completed
 Sutter Well Works firm name
 Stone county well located


LANDOWNER: Tom ANDERSON East Beach	description of formations encountered	from	to
GULFPORT, Miss. (mailing address)	Sand Clay Sand	0 28 190	28 190 236
WELL LOCATION:			
sec. 29 T-3 S R-11 E W 2 miles SE of Ten Mile (distance) (direction) (nearest town)			
WELL PURPOSE: home (home, irrigation, municipal, industrial)			
WELL COMPLETION DATA:			
(1) diameter (inches) 2"			
(2) total depth (feet) 236'			
(3) static water level (feet) _____ below/above top of ground.			
(4) casing galv (material), 231' (depth) 2' (size) if telescope see back.			
(5) screen 5' (length), 231' (depth to top) 2" (size), stainless steel (material)			
(6) pump Unknown (HP), _____ (yield gpm) (type power)			
(7) electric log no (yes or no) (organization running log)			
(8) how well bottom plugged BPI value			
DRILLERS REMARKS:			

JAN 12 1970

MISS. BD. OF
 WATER COMM.

If well telescopes please sketch and show depths.

GROUND LEVEL

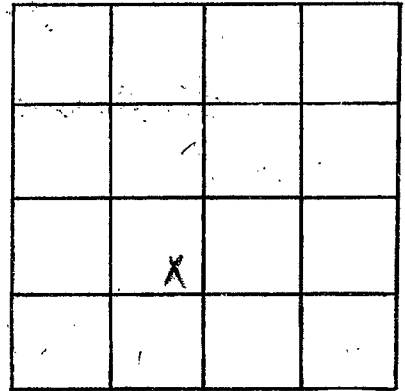

SECTION 29

Please indicate well location X.

ADDITIONAL INFORMATION

If more than one screen,
show locations of each on sketch.