

STONE
G 26
4-14-71

MISSISSIPPI
BOARD OF WATER COMMISSIONERS
416 North State Street
Jackson, Mississippi 39201

CODED

WATER WELL DRILLERS LOG

4-14 1971 Low Smith Stone
date well completed firm name county well located

LANDOWNER:	description of formations encountered	from to
<u>EO Trammell</u> <u>Wiggins Route</u> (mailing address)	<u>clay</u> <u>sand</u> <u>sand</u>	from <u>0</u> to <u>45</u> <u>45</u> <u>74</u>
WELL LOCATION:		
sec. <u>12</u> T. <u>3</u> S. R. <u>11</u> W. <u>6</u> miles <u>S-E</u> of <u>Wiggins</u> (distance) (direction) (nearest town)		
WELL PURPOSE: (home, irrigation, municipal, industrial)		
WELL COMPLETION DATA:		
(1) diameter (inches) <u>2 3/4</u>		
(2) total depth (feet) <u>74</u>		
(3) static water level (feet) <u>35</u> below above top of ground.		
(4) casing <u>Plastic</u> (material) (depth)		
(size) if telescope see back.		
(5) screen <u>5</u> <u>69</u> (length) (depth to top)		
(size) (material)		
(6) pump <u>1</u> <u>12</u> (HP) (yield gpm)		
<u>E</u> (type power)		
(7) electric log _____ (yes or no)		
(organization running log)		
(8) how well bottom plugged <u>Cap.</u>		
DRILLERS REMARKS:		


CODED

APR 19 1971

MISS. RD. OF
WATER COMM.

If well telescopes please sketch and show depths.

GROUND LEVEL

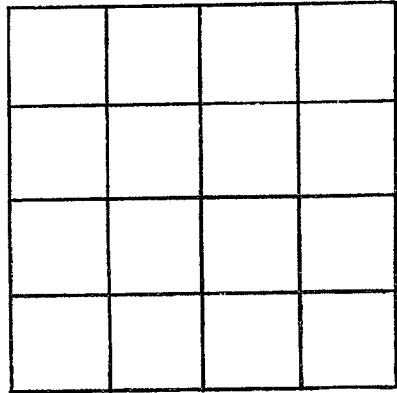

SECTION _____

Please indicate well location X.

ADDITIONAL INFORMATION

If more than one screen, show locations of each on sketch.