

STONE  
G 27  
4-15-71

MISSISSIPPI  
BOARD OF WATER COMMISSIONERS  
416 North State Street  
Jackson, Mississippi 39201

**CODED**

WATER WELL DRILLERS LOG

4-15 1971 Lewis Smith Stone  
date well completed firm name county well located

LANDOWNER:  
Fester Warden  
(mailing address)

description of formations encountered	from	to
Top S.	0	1
Clay	1	12
Sand	12	63
Sand		

WELL LOCATION:  
sec. 3 T. 9 S. R. 11 W.  
5 miles SE of Wiggins  
(distance) (direction) (nearest town)

WELL PURPOSE:  
(home, irrigation, municipal, industrial)

- WELL COMPLETION DATA:
- (1) diameter (inches) 2
  - (2) total depth (feet) 63
  - (3) static water level (feet) 20 below above top of ground.
  - (4) casing Plastic (material) (depth)
  - (size) if telescope see back.
  - (5) screen 5' 58" (length) (depth to top)
  - (size) (material)
  - (6) pump 1 (HP) 19 (yield gpm)
  - E (type power)
  - (7) electric log (yes or no)
  - (organization running log)
  - (8) how well bottom plugged Cap

**CODED**


APR 19 1971

MISS. BD. OF  
WATER COMMISSIONERS

DRILLERS REMARKS:

If well telescopes please sketch and show depths.

GROUND LEVEL

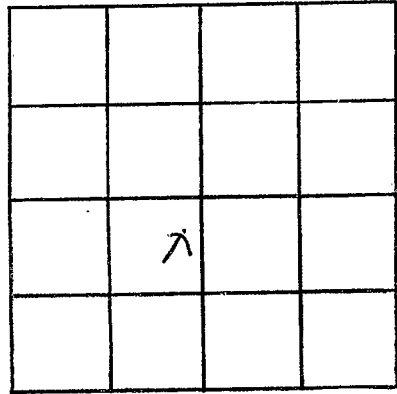

SECTION \_\_\_\_\_

Please indicate well location X.

ADDITIONAL INFORMATION

If more than one screen, show locations of each on sketch.