

STONE
G 29
9-24-70

MISSISSIPPI
 BOARD OF WATER COMMISSIONERS
 416 North State Street
 Jackson, Mississippi 39201

CODED

WATER WELL DRILLERS LOG

9-24 1970 Parnell Anderson Stone
 date well completed firm name county well located

LANDOWNER: Bunnie Preston
Route 1 Perkinsian
 (mailing address)

description of formations encountered	from	to
<u>Top Soil</u>	<u>0</u>	<u>3</u>
<u>Red Clay</u>	<u>3</u>	<u>19</u>
<u>Five Sand</u>	<u>19</u>	<u>38</u>
<u>Red Clay</u>	<u>38</u>	<u>72</u>
<u>Five Sand</u>	<u>72</u>	<u>94</u>
<u>Coarse Clay</u>	<u>94</u>	<u>106</u>

WELL LOCATION:
 sec. 12 T. 3 S. R. 11 E W.
12 miles E of Wiggins
 (distance) (direction) (nearest town)

WELL PURPOSE: Home
 (home, irrigation, municipal, industrial)

- WELL COMPLETION DATA:
- (1) diameter (inches) 2
 - (2) total depth (feet) 106
 - (3) static water level (feet) 30 below above top of ground.
 - (4) casing Plastic 100
 (material) (depth)
 if telescope see back.
 (size)
 - (5) screen 6 100
 (length) (depth to top)
2" Plastic
 (size) (material)
 - (6) pump 1 10
 (HP) (yield gpm)
Elec
 (type power)
 - (7) electric log
 (yes or no)
 - (organization running log)
 - (8) how well bottom plugged Back Wash Valve

CODED


JUN 11 1971

DRILLERS REMARKS:

MISS. Bd. of
 WATER COMMISSIONERS

If well telescopes please sketch and show depths.

GROUND LEVEL

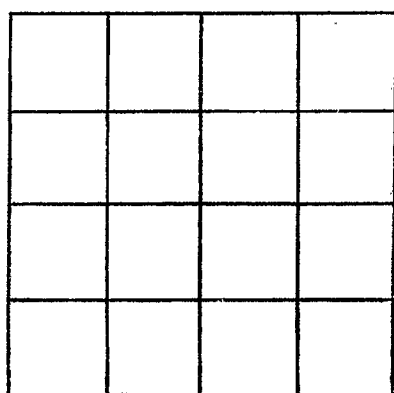

SECTION _____

Please indicate well location X.

ADDITIONAL INFORMATION

A series of horizontal lines for recording additional information, starting below the 'ADDITIONAL INFORMATION' header and extending to the bottom of the page.

If more than one screen, show locations of each on sketch.