

STONE
G30
2-2-71

MISSISSIPPI
BOARD OF WATER COMMISSIONERS
416 North State Street
Jackson, Mississippi 39201

CODED

WATER WELL DRILLERS LOG

2-2-71 date well completed 19 71 Barnee Anderson firm name Stone county well located

LANDOWNER: Mr. Winnie Bond
Perkinstown

description of formations encountered	from	to
TOP SOIL	0	2
Red Clay	2	24
Fine Sand	24	32
Red Clay	32	38
Coarse Sand	38	48

(mailing address)
WELL LOCATION:
sec. 34 T. 5 S. R. 11 E. W. 6
4 miles SE of Perkinstown
(distance) (direction) (nearest town)

WELL PURPOSE: Stone
(home, irrigation, municipal, industrial)

WELL COMPLETION DATA:
(1) diameter (inches) 2"
(2) total depth (feet) 48
(3) static water level (feet) _____ below above top of ground.
(4) casing Plastic (material), _____ (depth), _____ (size) if telescope see back.
(5) screen 6' (length), _____ (depth to top), 2" (size), Plastic (material)
(6) pump 1 (HP), 10 (yield gpm), Electric (type power)
(7) electric log no (yes or no)

(organization running log)

CODED

(8) how well bottom plugged Backwash Valve


DRILLERS REMARKS:

JUN 3 1971

MISS. BD. OF
WATER COMM.

If well telescopes please sketch and show depths.

GROUND LEVEL

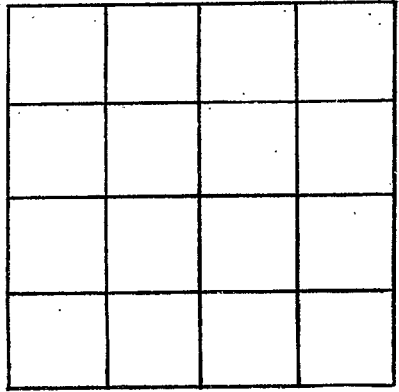

SECTION _____

Please indicate well location X.

ADDITIONAL INFORMATION

If more than one screen, show locations of each on sketch.