

STONE
G 31
12-23-70

MISSISSIPPI
BOARD OF WATER COMMISSIONERS
416 North State Street
Jackson, Mississippi 39201

CODED

WATER WELL DRILLERS LOG

12-23 1970 Parwell Anderson Stone
date well completed f/m name county well located

LANDOWNER: Bill Thompson
RT 1 Perkinston
(mailing address)

description of formations encountered	from	to
Top Soil + Sand	0	28
Red Clay	38	41
Fine Sand	41	56
Red clay	56	78
FINE SAND clay ST	78	105
Coarse SAND	105	125

WELL LOCATION:
sec. 2 T. 3 S. R. 11 W.
_____ miles _____ of _____
(distance) (direction) (nearest town)

WELL PURPOSE: HOM
(home, irrigation, municipal, industrial)

WELL COMPLETION DATA:
(1) diameter (inches) 2
(2) total depth (feet) 125
(3) static water level (feet) 60 below above top of ground.
(4) casing Plastic 119
(material) (depth)
_____ if telescope see back.
(size)
(5) screen 6 119
(length) (depth to top)
2" Plastic
(size) (material)
(6) pump 1 9
(HP) (yield gpm)
Elect
(type power)
(7) electric log _____
(yes or no)

(organization running log)

CODED

JUN 15 1971


(8) how well bottom plugged
Richmond Valve

DRILLERS REMARKS: _____

MISS. DIV. OF
WATER RESOURCES

If well telescopes please sketch and show depths.

GROUND LEVEL

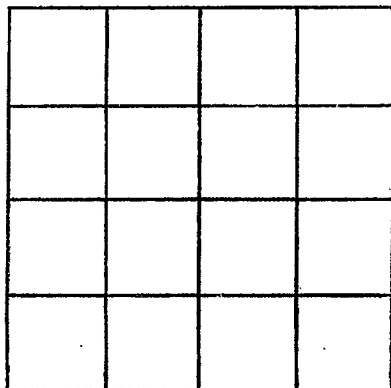

SECTION _____

Please indicate well location X.

ADDITIONAL INFORMATION

If more than one screen, show locations of each on sketch.