

STONE

G 33

WATER WELL DRILLERS LOG

CODED

9-7-60

Date: 9/7, 1960, Driller: _____ County: STONE

3140

(Name)

(1) Owner of Land: James P. Strickland
(Name)
Route H. Wiggins
(Address)

Description & Color of Materials
Sand, Clay, Red Clay, Shell, etc.

Thick-
ness
Feet

Depth
Feet

Red Clay
Sand Rest of
Way

20

(2) Location: NE 1/4, NE 1/4, Sec. 3 T3R11,
5 1/2 miles East of Wiggins
(distance) (direction) (Nearest Town)

(3) Topography: X
(Hilly) (Flat) (Level)

(4) Purpose of Well: Domestic
(Domestic Irrigation
Municipal, Industrial, Other)

Information upon completion of well:


- (1) Diameter 2 inches.
- (2) Total Depth 49 feet.
- (3) Water Level 20 feet below top of ground.
- (4) Cased to 49, Size 2
- (5) Screen: Size 2", Length 6'
- (6) Were any formations sealed against pollution?
_____ yes, _____ no.

CODED

If YES depth of formation _____

Why _____

Drillers Remarks: This well
is an all P.V.C. pipe
Pipe & Point

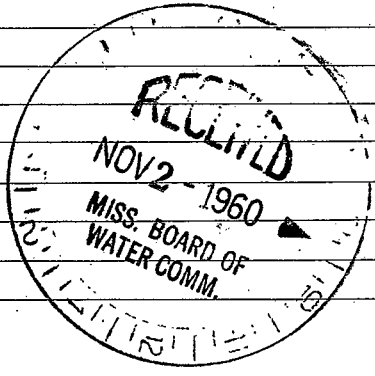

(Use Back Side)

Well No.

