

STONE

G34

WATER WELL DRILLERS LOG

CODED

9-14-60

Date: 9/14, 1960, Driller:

County STONE

584
619

(Name)

(1) Owner of Land: JERREI BOND
(Name)

Description & Color of Materials Sand, Clay, Red Clay, Shell, etc.	Thick- ness Feet	Depth Feet
yellow clay		0-10
yellow sand		10-94

Wiggins, Miss
(Address)

SW CORNER
(2) Location: NW 1/4, NE 1/4, Sec. 3 T3R11

5 miles EAST of Wiggins
(distance) (direction) (Nearest Town)

(3) Topography: X
(Hilly) (Flat) (Level)

(4) Purpose of Well: DOMESTIC
(Domestic Irrigation
Municipal, Industrial, Other)

Information upon completion of well:

(1) Diameter 2 inches.

(2) Total Depth 94 feet.

(3) Water Level 60 feet below top of ground.

(4) Cased to _____, Size _____

(5) Screen: Size 2, Length 10

(6) Were any formations sealed against pollution?


_____ yes, X no.

If YES depth of formation _____

Why _____

Drillers Remarks: _____

CODED

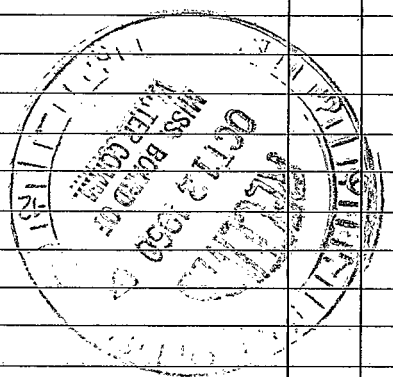

Well No.

(Use Back Side)

