

12 $\overline{) 2.5}$
 30.0
 24
 60

4
3
2
1

12
9
6
3
30

STONE
G36
8-27-71

MISSISSIPPI
 BOARD OF WATER COMMISSIONERS
 416 North State Street
 Jackson, Mississippi 39201

WATER WELL DRILLERS LOG

8-27 1971 Pernell Anderson Stone
 date well completed firm name county well located

LANDOWNER: Kerritt Herrin
Rt 1 Perkinston
 (mailing address)

description of formations encountered	from	to
TOR Soil	0	3
Red Clay	3	23
Fin Sand	23	35
Red Clay	35	41
Sand with Clay ST.	41	90
Sand	70	85

WELL LOCATION:
 sec. 5 T. 3 S. R. 11 W.
4 miles S of Wiggins
 (distance) (direction) (nearest town)

WELL PURPOSE: Home
 (home, irrigation, municipal, industrial)

- WELL COMPLETION DATA:
- (1) diameter (inches) 2
 - (2) total depth (feet) 85
 - (3) static water level (feet) 50 below above top of ground.
 - (4) casing Pvc. 80
 (material) (depth)
 (size) If telescope see back.
 - (5) screen 5 80
 (length) (depth to top)
2 P.V.C.
 (size) (material)
 - (6) pump 1 10
 (HP) (yield gpm)
Electric
 (type power)
 - (7) electric log _____
 (yes or no)


 (organization running log)
 - (8) how well bottom plugged Backwash Valve

DRILLERS REMARKS:

FILED 8-27-71
 MISS. BD. OF
 WATER COMMISSIONERS

If well telescopes please sketch and show depths.

GROUND LEVEL

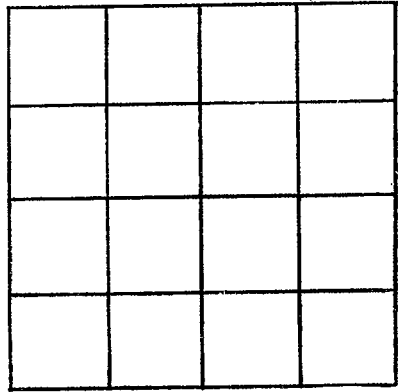

SECTION _____

Please indicate well location X.

ADDITIONAL INFORMATION

If more than one screen, show locations of each on sketch.