

STONE  
G 40  
10-12-71

MISSISSIPPI  
BOARD OF WATER COMMISSIONERS  
416 North State Street  
Jackson, Mississippi 39201

CODED

WATER WELL DRILLERS LOG

10-12-1971 Parnell Anderson Stone  
date well completed firm name county well located

LANDOWNER: Bobby Gipson  
AT 1 Perkinson

description of formations encountered	from	to
TOP Soil	0	4
Red Sand	4	18
Fine Sand	18	31
Pink clay	31	35
Fine Sand	35	46
Coarse Sand	46	57

(mailing address)

WELL LOCATION:  
sec. 4 T 3 R 11 S W  
5 miles E of Perkinson  
(distance) (direction) (nearest town)

WELL PURPOSE: Home  
(home, irrigation, municipal, industrial)

WELL COMPLETION DATA:

- (1) diameter (inches) 2
- (2) total depth (feet) 62
- (3) static water level (feet) 3 below top of ground.
- (4) casing PVC 57 (material) (depth)
- (size) If telescope see back.
- (5) screen 5 57 (length) (depth to top)
- 2 PVC (size) (material)
- (6) pump 1 11 (HP) (yield gpm)
- F/lec (type power)
- (7) electric log (yes or no)
- (organization running log)
- (8) how well bottom plugged Backwash valve


CODED

DRILLERS REMARKS:

DEC 8 1971

If well telescopes please sketch and show depths.

GROUND LEVEL

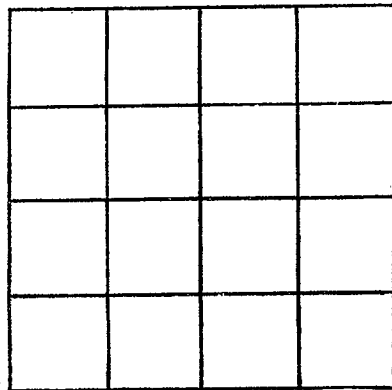

SECTION \_\_\_\_\_

Please indicate well location X.

ADDITIONAL INFORMATION

If more than one screen,  
show locations of each on sketch.