

MISSISSIPPI  
BOARD OF WATER COMMISSIONERS  
416 North State Street  
Jackson, Mississippi 39201

**CODED**

WATER WELL DRILLERS LOG

STONE  
G41  
12-22-72

12-22 1972 Parnell Anderson STONE  
date well completed firm name county well located

LANDOWNER: Vick Bailey

Wiggins ms

(mailing address)

description of formations encountered

from to

TOP Soil	0	2
Red clay	2	24
Fine Red Sand	24	38
Red clay	38	57
Fine Sand with clay s	57	110
Red clay	110	115
Coarse Sand + Grav	115	132

WELL LOCATION:

sec. 6 T. 3 S. R. 11 E. W.  
4 miles S of Wiggins  
(distance) (direction) (nearest town)

WELL PURPOSE: RENT HOUSE  
(home, irrigation, municipal, industrial)

WELL COMPLETION DATA:

- (1) diameter (inches) 2
- (2) total depth (feet) 132
- (3) static water level (feet) 56 below above top of ground.
- (4) casing Plastic, 127  
(material) (depth)
- (size) if telescope see back.
- (5) screen 5, 127  
(length) (depth to top)
- (size) (material)
- (6) pump 1, 12  
(HP) (yield gpm)
- Elect  
(type power)
- (7) electric log (yes or no) \_\_\_\_\_  
(organization running log) \_\_\_\_\_
- (8) how well bottom plugged Backwash Valve

**CODED**


DRILLERS REMARKS:

DEC 9 1972

MISS. BD. OF  
WATER COMM

If well telescopes please sketch and show depths.

GROUND LEVEL

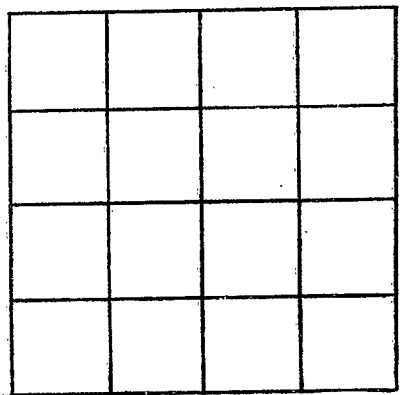

SECTION \_\_\_\_\_

Please indicate well location X.

ADDITIONAL INFORMATION

A series of horizontal lines providing space for additional information.

If more than one screen, show locations of each on sketch.