

MISSISSIPPI  
BOARD OF WATER COMMISSIONERS  
416 North State Street  
Jackson, Mississippi 39201

**CODED**

STONE  
G42  
3-24-72

WATER WELL DRILLERS LOG

3-24 1972 Parnell Anderson Stone  
date well completed firm name county well located

LANDOWNER: FRY / FOUNDATION  
RT 1 PERKINSTON

description of formations encountered	from	to
TOP Soil	0	3
Red Sand	3	26
Red Clay	20	34
Fine Sand with clay ST	34	81
Pink Clay	81	85
Fine Sand	85	92
COARSE SAND	92	105

(mailing address)

WELL LOCATION:  
sec. 3 T 3 S R 11 E W  
5 miles E of Wiggins  
(distance) (direction) (nearest town)

WELL PURPOSE: HOME  
(home, irrigation, municipal, industrial)

- WELL COMPLETION DATA:
- (1) diameter (inches) 2
  - (2) total depth (feet) 105
  - (3) static water level (feet) 31 below ~~above~~ top of ground.
  - (4) casing Plastic, 100  
(material) (depth)
  - (size) if telescope see back.
  - (5) screen 5' 100  
(length) (depth to top)
  - 2" Plastic  
(size) (material)
  - (6) pump 1 12  
(HP) (yield gpm)
  - Elect  
(type power)
  - (7) electric log \_\_\_\_\_  
(yes or no)
  - \_\_\_\_\_  
(organization running log)
  - (8) how well bottom plugged  
Backwash valve


**CODED**

DRILLERS REMARKS:

DEC 11 1972

If well telescopes please sketch and show depths.

GROUND LEVEL

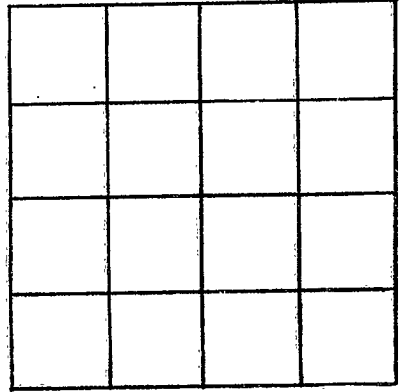

SECTION \_\_\_\_\_

Please indicate well location X.

ADDITIONAL INFORMATION

If more than one screen,  
show locations of each on sketch.