

MISSISSIPPI
BOARD OF WATER COMMISSIONERS
416 North State Street
Jackson, Mississippi 39201

WATER WELL DRILLERS LOG

CODED

STONE
G43
1-12-72

1-12-72 date well completed 1972 Parnell Anderson firm name Stone county well located

LANDOWNER: Michael H. Watt
Root 1 Perkinsham
(mailing address)

| description of formations encountered | from | to |
|---------------------------------------|------|----|
| TOP Soil | 0 | 3 |
| Red Sandy Clay | 3 | 24 |
| Fine Red Sand | 24 | 38 |
| Red clay | 38 | 54 |
| Fine Sand + clay | 54 | 78 |
| Coarse Sand | 78 | 99 |

WELL LOCATION:
sec. 12 T-3 S R-11 W
11 miles S-E of Wiggins
(distance) (direction) (nearest town)

WELL PURPOSE: Home
(home, irrigation, municipal, industrial)

- WELL COMPLETION DATA:
- (1) diameter (inches) 2
 - (2) total depth (feet) 99
 - (3) static water level (feet) 30 below top of ground.
 - (4) casing Plastic, 94
(material) (depth)
 - (size) if telescope see back.
 - (5) screen 5, 94
(length) (depth to top)
 - 2, Plastic
(size) (material)
 - (6) pump 1, 12
(HP) (yield gpm)
 - Elec
(type power)
 - (7) electric log _____
(yes or no)
 - _____
(organization running log)
 - (8) how well bottom plugged
Backlash valve


CODED

DRILLERS REMARKS:

DEC 11 1972

If well telescopes please
sketch and show depths.

GROUND LEVEL

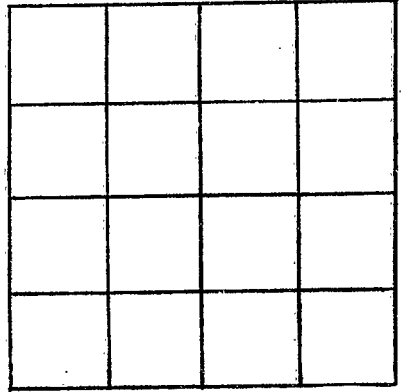

SECTION _____

Please indicate well location X.

ADDITIONAL INFORMATION

If more than one screen,
show locations of each on sketch.