

MISSISSIPPI  
BOARD OF WATER COMMISSIONERS  
416 North State Street  
Jackson, Mississippi 39201

**CODED**

WATER WELL DRILLERS LOG

STONE  
G 44  
2-11-72

2-11-1972 date well completed  
Pernell Anderson firm name  
STONE county well located

LANDOWNER: Shirley Oates  
Perkinsior

description of formations encountered

from to

TOP Soil	0	3
Sand	3	28
Red clay	28	35
Sand with clay ST	35	90
CORSE SAND	90	105

(mailing address)

WELL LOCATION:

sec. 18 T-3 S R-11 E W  
1/2 miles E of Perkinsior  
(distance) (direction) (nearest town)

WELL PURPOSE: Home  
(home, irrigation, municipal, industrial)

WELL COMPLETION DATA:

- (1) diameter (inches) 2
- (2) total depth (feet) 105
- (3) static water level (feet) 8 below top of ground.
- (4) casing Plastic, 100 (material) (depth)
- (size) if telescope see back.
- (5) screen 5" (length), 100' (depth to top)
- 2" Plastic (size) (material)
- (6) pump 1/2 (HP), 7 (yield gpm)
- Elect (type power)
- (7) electric log (yes or no)
- (organization running log)

**CODED**


(8) how well bottom plugged  
Backwash Valve

DRILLERS REMARKS:

REC 11 1972

If well telescopes please sketch and show depths.

GROUND LEVEL

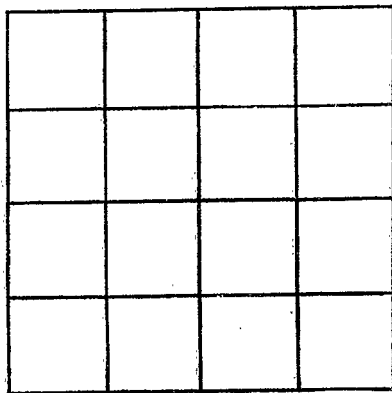

SECTION \_\_\_\_\_

Please indicate well location X.

ADDITIONAL INFORMATION

If more than one screen, show locations of each on sketch.