

STONE  
G 45  
2-14-72

MISSISSIPPI  
BOARD OF WATER COMMISSIONERS  
416 North State Street  
Jackson, Mississippi 39201

**CODED**

WATER WELL DRILLERS LOG

2-14 1972 Parnell Anderson Stone  
date well completed firm name county well located

LANDOWNER: Mell W. Donati  
RT 1 Parkinston

description of formations encountered	from	to
Top Soil	0	3
Reddaway Clay	3	37
Coarse Sand	37	310
Red Clay	30	53
Fine Sand with clay str.	53	91
Coarse Sand	91	114

(mailing address)

WELL LOCATION:  
sec. 2 T. 3 N. R. 11 E.  
S. W.  
8 miles E of Wiggins  
(distance) (direction) (nearest town)

WELL PURPOSE: Home  
(home, irrigation, municipal, industrial)

- WELL COMPLETION DATA:
- (1) diameter (inches) 2
  - (2) total depth (feet) 114
  - (3) static water level (feet) 58 below top of ground.
  - (4) casing Plastic, 109  
(material) (depth)
  - \_\_\_\_\_ if telescope see back.  
(size)
  - (5) screen 5', 109  
(length) (depth to top)
  - 2", Plastic  
(size) (material)
  - (6) pump 1, 40  
(HP) (yield gpm)
  - Elect  
(type power)
  - (7) electric log \_\_\_\_\_  
(yes or no)
  - \_\_\_\_\_ (organization running log)
  - (8) how well bottom plugged  
Backwash valve


**CODED**

DRILLERS REMARKS:

REC 11 1972

If well telescopes please sketch and show depths.

GROUND LEVEL

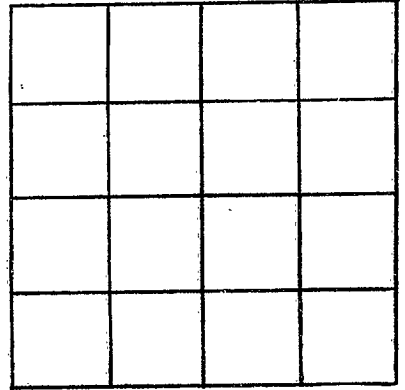

SECTION \_\_\_\_\_

Please indicate well location X.

ADDITIONAL INFORMATION

If more than one screen, show locations of each on sketch.