

STONE
G 46
2-19-72

MISSISSIPPI
BOARD OF WATER COMMISSIONERS
416 North State Street
Jackson, Mississippi 39201

CODED

WATER WELL DRILLERS LOG

2-19 1972 Raymond Anderson Stone
date well completed firm name county well located

LANDOWNER: Harold Brooks
Mrs Henry Mis
(mailing address)

description of formations encountered	from	to
TOP Soil	0	2
Sand	2	31
Pink Clay	31	38
Fine Sand	38	69
Coarse Sand & gravel	69	81

WELL LOCATION:
sec. 32 T 3 N R 11 E
S W
3 miles E of Perkins
(distance) (direction) (nearest town)

WELL PURPOSE: Home
(home, irrigation, municipal, industrial)

- WELL COMPLETION DATA:
- (1) diameter (inches) 3
 - (2) total depth (feet) 81
 - (3) static water level (feet) 59 below ~~above~~ top of ground.
 - (4) casing Plastic, 76,
(material) (depth)
(size) if telescope see back.
 - (5) screen 5", 76
(length) (depth to top)
2", Plastic
(size) (material)
 - (6) pump 1 10
(HP) (yield gpm)
Elect
(type power)
 - (7) electric log (yes or no) _____
(organization running log) _____
 - (8) how well bottom plugged Backwash Valve


CODED

DRILLERS REMARKS:

DEC 11 1972

If well telescopes please sketch and show depths.

GROUND LEVEL

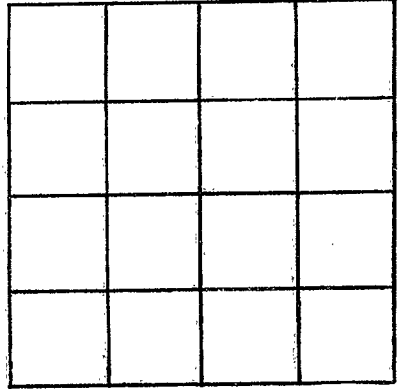

SECTION _____

Please indicate well location X.

ADDITIONAL INFORMATION

If more than one screen, show locations of each on sketch.