

STONE  
G 48

1-18-23

MISSISSIPPI  
BOARD OF WATER COMMISSIONERS  
416 North State Street  
Jackson, Mississippi 39201

CODEL

WATER WELL DRILLERS LOG

1-18 19 72 PARNELL ANDERSON Stone  
date well completed firm name county well located

LANDOWNER: Homer Rainwater

Perkinstou, Mississippi

(mailing address)

WELL LOCATION:

sec. 14 T 3 S R 11 E W  
1 miles south of Perkinstou  
(distance) (direction) (nearest town)

WELL PURPOSE: Home  
(home, irrigation, municipal, industrial)

WELL COMPLETION DATA:

- (1) diameter (inches) 2
- (2) total depth (feet) 97
- (3) static water level (feet) 50 below above top of ground.
- (4) casing plastic, 92 (material) (depth)  
(size) if telescope see back.
- (5) screen 5' 92' (length) (depth to top)  
2 plastic (size) (material)
- (6) pump 1 8 (HP) (yield gpm)  
Electric (type power)
- (7) electric log (yes or no)  
(organization running log)
- (8) how well bottom plugged  
BACKWASH valve

description of formations encountered

from to

Top Soil	0	4
White Clay	4	34
Blue Clay	34	65
Fine Sand	65	85
Coarse Sand	85	95

CODEL

DRILLERS REMARKS:


MAY 25 1979

MISS. BD

WATER

If well telescopes please sketch and show depths.

GROUND LEVEL

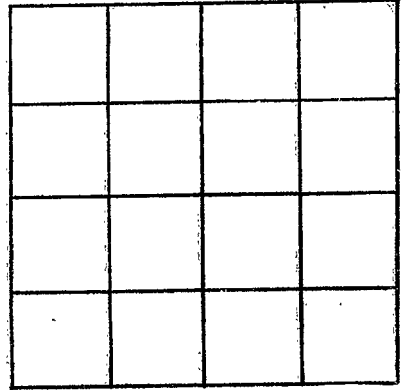

SECTION \_\_\_\_\_

Please indicate well location X.

ADDITIONAL INFORMATION

If more than one screen,  
show locations of each on sketch.