

STONE
G99
4-21-72

MISSISSIPPI
BOARD OF WATER COMMISSIONERS
416 North State Street
Jackson, Mississippi 39201

CODED

WATER WELL DRILLERS LOG

4-21 1972 Parnell Anderson Stone
date well completed firm name county well located

LANDOWNER: AUSTON ANDERSON
RT 1 PERKINSTON

description of formations encountered

from to

Top Soil	0	3
Sand	3	31
White Clay	31	37
Coarse Sand	37	60

(mailing address)

WELL LOCATION:

sec. 14 T. 3 S. R. 11 W.
16 miles S-E of Wiggins
(distance) (direction) (nearest town)

WELL PURPOSE: Home
(home, irrigation, municipal, industrial)

WELL COMPLETION DATA:

(1) diameter (inches) 2
(2) total depth (feet) 60
(3) static water level (feet) 16 below top of ground.

(4) casing Pastic 54
(material) (depth)

_____ if telescope see back.
(size)

(5) screen 6 54
(length) (depth to top)

2 Stainless Steel
(size) (material)

(6) pump 1/2 7
(HP) (yield gpm)

Elect
(type power)

(7) electric log _____
(yes or no)

_____ (organization running log)


(8) how well bottom plugged
Backwash Valve

DRILLERS REMARKS:

MAY 25 1972

If well telescopes please
sketch and show depths.

GROUND LEVEL

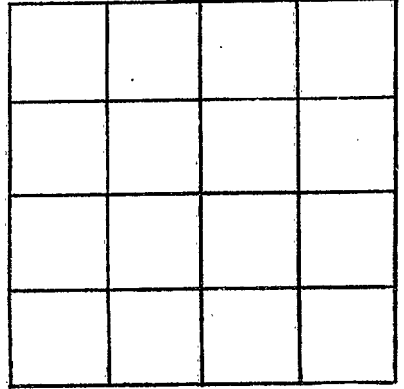

SECTION _____

Please indicate well location X.

ADDITIONAL INFORMATION

If more than one screen,
show locations of each on sketch.