

STONE
G 50
2-21-73

MISSISSIPPI
BOARD OF WATER COMMISSIONERS
416 North State Street
Jackson, Mississippi 39201

CODED

WATER WELL DRILLERS LOG

2-21 1973 PARWELL ANDERSON Stone
date well completed firm name county well located

LANDOWNER: Charles Parker
Route 1, Perkinston, Miss

description of formations
encountered

from

to

Top Soil

0

4

white clay

4

65

(mailing address)

WELL LOCATION:

sec 6 T 3 N R 11 E
S W
4 miles South of Wiggins
(distance) (direction) (nearest town)

Brown clay

65

100

Coarse Sand

100

125

WELL PURPOSE: Industrial
(home, irrigation, municipal, industrial)

WELL COMPLETION DATA:

(1) diameter (inches) 2
(2) total depth (feet) 125
(3) static water level (feet) 70 below above
top of ground.

(4) casing plastic, 120
(material) (depth)

(size) if telescope see back.

(5) screen 5', 120
(length) (depth to top)

2", plastic
(size) (material)

(6) pump 1, 9
(HP) (yield gpm)

Electric
(type power)

(7) electric log (yes or no)

(organization running log)

(8) how well bottom plugged
Backwash Valve


CODED

DRILLERS REMARKS:

MAY 25 1973

If well telescopes please sketch and show depths.

GROUND LEVEL

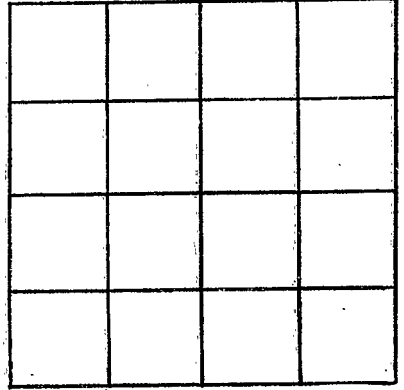

SECTION _____

Please indicate well location X.

ADDITIONAL INFORMATION

If more than one screen, show locations of each on sketch.