

STONE
G52
3-9-73

MISSISSIPPI
BOARD OF WATER COMMISSIONERS
416 North State Street
Jackson, Mississippi 39201
WATER WELL DRILLERS LOG

CODED

3-9 1973 PARNELL ANDERSON Stone
date well completed firm name county well located

LANDOWNER: FRANKLIN RADERZ

Route 2, Perkinston, Miss

(mailing address)

WELL LOCATION:

sec. 12 T. 3 S. R. 11 W.
9 miles west of Perkinston
(distance) (direction) (nearest town)

WELL PURPOSE: Home
(home, irrigation, municipal, industrial)

WELL COMPLETION DATA:

- (1) diameter (inches) 2
- (2) total depth (feet) 100
- (3) static water level (feet) 70 below above top of ground.
- (4) casing plastic, 95,
(material) (depth)
 if telescope see back.
(size)
- (5) screen 5, 95
(length) (depth to top)
2", plastic
(size) (material)
- (6) pump 1, 7
(HP) (yield gpm)
Electric
(type power)
- (7) electric log
(yes or no)

(organization running log)
- (8) how well bottom plugged Backwash valve

description of formations encountered

from to

<u>Top Soil</u>	<u>0</u>	<u>4</u>
<u>Red Clay</u>	<u>4</u>	<u>28</u>
<u>Fine Sand</u>	<u>28</u>	<u>80</u>
<u>Coarse Sand</u>	<u>80</u>	<u>100</u>

CODED


MAY 25 1973

DRILLERS REMARKS:

MISS. BD. OF
WATER COM.

If well telescopes please sketch and show depths.

GROUND LEVEL

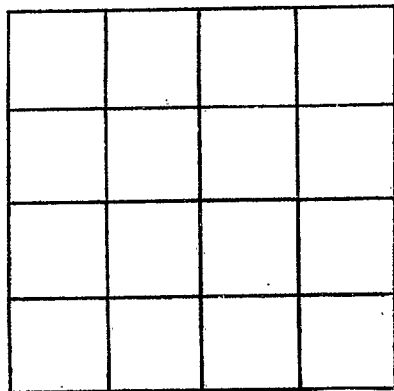

SECTION _____

Please indicate well location X.

ADDITIONAL INFORMATION

If more than one screen, show locations of each on sketch.