

STONE
G 53
7-12-73

MISSISSIPPI
 BOARD OF WATER COMMISSIONERS
 416 North State Street
 Jackson, Mississippi 39201

CODED

WATER WELL DRILLERS LOG

7-12-1973 Pernell Anderson Stone
 date well completed firm name county well located

LANDOWNER:
Tommy A Warden
Rt 1 Wiggins
 (mailing address)

description of formations encountered	from	to
<u>Top Soil</u>	<u>0</u>	<u>6</u>
<u>Red Sand</u>	<u>6</u>	<u>35</u>
<u>Fine Sand</u>	<u>45</u>	<u>80</u>
<u>Coarse Sand</u>	<u>80</u>	<u>105</u>

WELL LOCATION:
 sec. 2 T. 3 R. 11
5 miles SW of W. Leg.
 (distance) (direction) (nearest town)

WELL PURPOSE: H O M E
 (home, irrigation, municipal, industrial)

- WELL COMPLETION DATA:
- (1) diameter (inches) 2"
 - (2) total depth (feet) 105'
 - (3) static water level (feet) 30' below above top of ground.
 - (4) casing Plastic, 100'
 (material) (depth)
 (size) if telescope see back.
 - (5) screen 5', 100'
 (length) (depth to top)
2", Plastic
 (size) (material)
 - (6) pump 1, 8
 (HP) (yield gpm)
Elect
 (type power)
 - (7) electric log no
 (yes or no)
 - (organization running log)
 - (8) how well bottom plugged Back wash valve


CODED

DRILLERS REMARKS:

NOV 5 1973

If well telescopes please sketch and show depths.

GROUND LEVEL

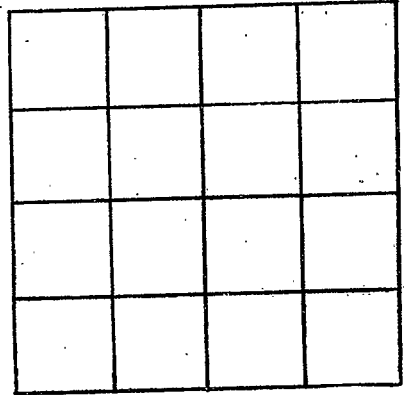

SECTION _____

Please indicate well location X.

ADDITIONAL INFORMATION

If more than one screen, show locations of each on sketch.