

STONE
G61
2-20-74

MISSISSIPPI
BOARD OF WATER COMMISSIONERS
416 North State Street
Jackson, Mississippi 39201

CODED

WATER WELL DRILLERS LOG

2-20 1974 Parrell Henderson Stone
date well completed firm name county well located

LANDOWNER:
Junior Frank
R.A. Perkinson
(mailing address)

description of formations encountered	from	to
Top Soil	0	4
Pink Clay	4	30
Sand Clay	30	42
Thin Sand	42	88
Course Sand	88	94
Pink Clay	94	105
Course Sand	105	120

WELL LOCATION:
sec. 19 T. 3 S. R. 11 E.
1 miles (distance) S of Perkin (direction) (nearest town)

WELL PURPOSE: HOME
(home, irrigation, municipal, industrial)

- WELL COMPLETION DATA:
- (1) diameter (inches) 2"
 - (2) total depth (feet) 120
 - (3) static water level (feet) 46 below top of ground.
 - (4) casing Plastic, 120' (material) (depth)
 - (size) if telescope see back.
 - (5) screen 5', 115' (length) (depth to top)
 - 2", Plastic (size) (material)
 - (6) pump 1, 10 (HP) (yield gpm)
 - E best (type power)
 - (7) electric log no (yes or no)
 - (organization running log)
 - (8) how well bottom plugged Backwash valve

CODED


MAR - 6 1974

DRILLERS REMARKS:

MISS. BD. OF W.

If well telescopes please sketch and show depths.

GROUND LEVEL

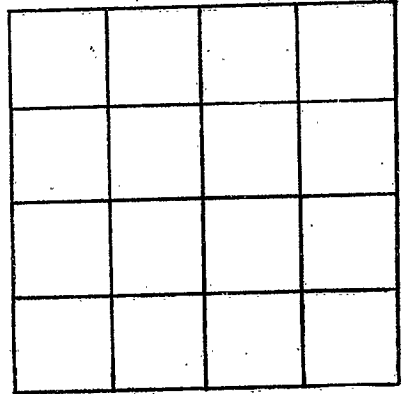

SECTION _____

Please indicate well location X.

ADDITIONAL INFORMATION

If more than one screen, show locations of each on sketch.