

STONE
G 62
3-27-74

MISSISSIPPI
BOARD OF WATER COMMISSIONERS
416 North State Street
Jackson, Mississippi 39201

CODED

WATER WELL DRILLERS LOG

3-27 1974 Perme Anderson Stone
date well completed firm name county well located

LANDOWNER:
Virginia Townsend
Rt A Park
(mailing address)

description of formations encountered	from	to
<u>Top Soil</u>	<u>0</u>	<u>4</u>
<u>Red Clay</u>	<u>4</u>	<u>20</u>
<u>white clay</u>	<u>20</u>	<u>30</u>
<u>Coarse Sand</u>	<u>30</u>	<u>35</u>

WELL LOCATION:
sec. 2 T. 3 N. R. 11 W.
S miles E of Wlog
(distance) (direction) (nearest town)

WELL PURPOSE: HOME
(home, irrigation, municipal, industrial)

CODED


- WELL COMPLETION DATA:
- (1) diameter (inches) 2"
 - (2) total depth (feet) 35'
 - (3) static water level (feet) 50' below top of ground.
 - (4) casing Plastic, 51'
(material) (depth)
 - _____ If telescope see back.
(size)
 - (5) screen 5' 81'
(length) (depth to top)
 - 2" Plastic
(size) (material)
 - (6) pump 1 10
(HP) (yield gpm)
 - Elect
(type power)
 - (7) electric log no
(yes or no)
 - _____ (organization running log)
 - (8) how well bottom plugged
Back wash tubes

DRILLERS REMARKS:

APR - 5 1974

If well telescopes please sketch and show depths.

GROUND LEVEL

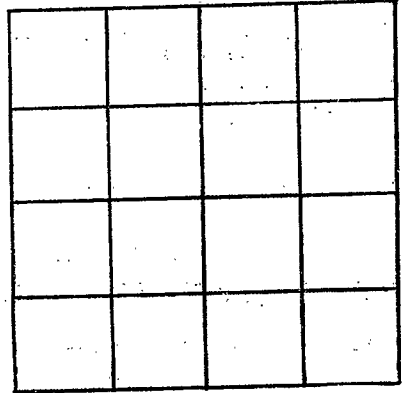

SECTION _____

Please indicate well location X.

ADDITIONAL INFORMATION

If more than one screen, show locations of each on sketch.