

STONE
 G 63
 3-20-74

MISSISSIPPI
 BOARD OF WATER COMMISSIONERS
 416 North State Street
 Jackson, Mississippi 39201

CODED

WATER WELL DRILLERS LOG

3-20 1974 Arnell Anderson Stone
 date well completed firm name county well located

LANDOWNER:
Mary K. Ireland
Bt J. Pelkinton
 (mailing address)

description of formations encountered	from	to
<u>Top Soil</u>	<u>0</u>	<u>4</u>
<u>Pink Clay</u>	<u>4</u>	<u>26</u>
<u>Thin Sand</u>	<u>26</u>	<u>60</u>
<u>Coarse Sand</u>	<u>60</u>	<u>85</u>

WELL LOCATION:
 sec. 5 T. 3 S. R. 21 E.
6 miles S of Wiggins
 (distance) (direction) (nearest town)

WELL PURPOSE: HOME
 (home, irrigation, municipal, industrial)

WELL COMPLETION DATA:

(1) diameter (inches) 2"

(2) total depth (feet) 85'

(3) static water level (feet) 5' below top of ground.

(4) casing Plastic, 80'
 (material) (depth)
 (size) if telescope see back.

(5) screen 5', 20'
 (length) (depth to top)
2", Plastic
 (size) (material)

(6) pump 1 12
 (HP) (yield gpm)
Elect
 (type power)

(7) electric log no
 (yes or no)
no
 (organization running log)

(8) has well bottom plugged
Back with a dol

CODED


RECORDED
 APR - 5 1974

DRILLERS REMARKS:

MISS. Bd. OF WATER COMM.

If well telescopes please sketch and show depths.

GROUND LEVEL

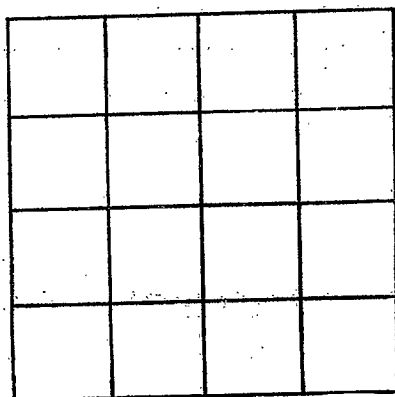

SECTION _____

Please indicate well location X.

ADDITIONAL INFORMATION

If more than one screen, show locations of each on sketch.