

MISSISSIPPI
BOARD OF WATER COMMISSIONERS
416 North State Street
Jackson, Mississippi 39201

CODED

WATER WELL DRILLERS LOG

STONE
G 64
5-17-74

05-17-1974 Panel Anderson Stone
date well completed firm name county well located

LANDOWNER:

Gerald Preston
Rt 4 Perk
(mailing address)

description of formations encountered

from to

Top Soil	0	4
Red Clay	4	18
Fine Sand	18	60
White Clay	60	85
Coarse Sand	85	105

WELL LOCATION:

sec. 11 T. 3 R. 11
6 miles S-E of Perk
(distance) (direction) (nearest town)

WELL PURPOSE: HOME
(home, irrigation, municipal, industrial)

WELL COMPLETION DATA:


- (1) diameter (inches) 2"
- (2) total depth (feet) 105'
- (3) static water level (feet) 28' below top of ground
- (4) casing Plastic 100'
(material) (depth)
- (size) If telescope see back.
- (5) screen 5', 100'
(length) (depth to top)
- 2", Plastic
(size) (material)
- (6) pump 1 10
(HP) (yield gpm)
- Electric
(type power)
- (7) electric log no
(yes or no)

CODED

(organization running log)

(8) has well bottom plugged Back with wall

DRILLERS REMARKS:

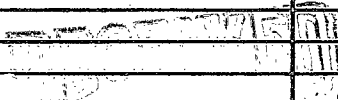


JUN - 6 1974

MISS. BD. OF WATER COMMISSIONERS

If well telescopes please sketch and show depths.

GROUND LEVEL

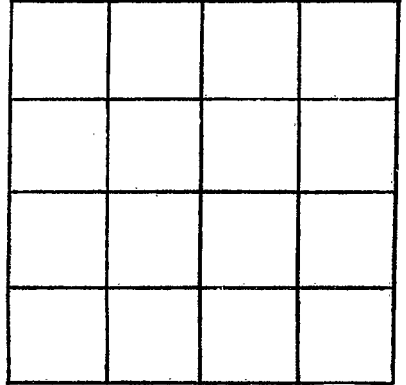

SECTION _____

Please indicate well location X.

ADDITIONAL INFORMATION

If more than one screen,
show locations of each on sketch.