

STONE
G 65
5-13-74

MISSISSIPPI
BOARD OF WATER COMMISSIONERS
416 North State Street
Jackson, Mississippi 39201

WATER WELL DRILLERS LOG CODED

5-13-74 date well completed
Dannell Anderson Stone firm name
Stone county well located

LANDOWNER:
Wesley Riehl Jr.
Rt 1, Parklinton
(mailing address)

description of formations encountered	from	to
Top Soil	0	3
Gray Clay	3	14
Fine Sand	14	48
Coarse Sand	48	61

WELL LOCATION:
sec. 13 T 3 R 11
6 miles NE of Park
(distance) (direction) (nearest town)

WELL PURPOSE: HOME
(home, irrigation, municipal, industrial)

WELL COMPLETION DATA:

(1) diameter (inches) 2"

(2) total depth (feet) 61'

(3) static water level (feet) 4' below top of ground.

(4) casing Plastic, 55'
(material) (depth)

(size) If telescope see back.

(5) screen 6' 55'
(length) (depth to top)
2" Plastic
(size) (material)

(6) pump 1 13
(HP) (yield gpm)
E lect
(type power)

(7) electric log no
(yes or no)

(organization running log)

(8) how well bottom plugged
Back Well Valve

CODED


DRILLERS REMARKS:
JAN - 6 1974

DRILLERS REMARKS:

MISS. Bd. of Water Comm.

If well telescopes please sketch and show depths.

GROUND LEVEL

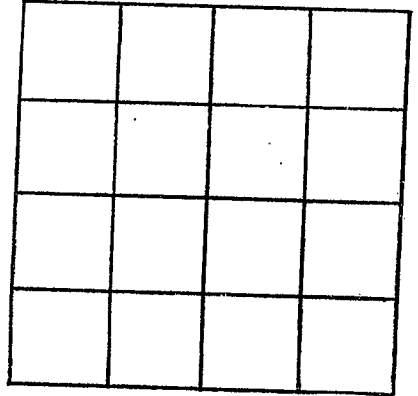

SECTION _____

Please indicate well location X.

ADDITIONAL INFORMATION

If more than one screen,
show locations of each on sketch.