

STONE
G 66
5-8-74

MISSISSIPPI
BOARD OF WATER COMMISSIONERS
416 North State Street
Jackson, Mississippi 39201

CODED

WATER WELL DRILLERS LOG

5-8 1974 Parnell Andersen Stone
date well completed firm name county well located

LANDOWNER:	description of formations encountered	from	to
Millard B. Caldwell Rt 1 Perk (mailing address)			
WELL LOCATION: sec. 33 T. 3 R. 11 2 miles E of Perk (distance) (direction) (nearest town)	Fine Sand	3	100
WELL PURPOSE: (home, irrigation, municipal, industrial)	Coarse Sand	100	105
WELL COMPLETION DATA:			
(1) diameter (inches) 2"			
(2) total depth (feet) 105'			
(3) static water level (feet) 78' below top of ground.			
(4) casing <u>Plastic</u> 100' (material) (depth)			
_____ if telescope see back. (size)			
(5) screen <u>5'</u> <u>100'</u> (length) (depth to top)			
<u>2"</u> <u>Plastic</u> (size) (material)			
(6) pump <u>1</u> <u>8</u> (HP) (yield gpm)			
<u>Elect</u> (type power)			
(7) electric log <u>no</u> (yes or no)			
_____ (organization running log)			
(8) how well bottom plugged <u>Back washer</u>			
DRILLERS REMARKS:			


CODED

JUN 6 1974

MISS. Bd. OF WATER COMMISSIONERS

If well telescopes please sketch and show depths.

GROUND LEVEL

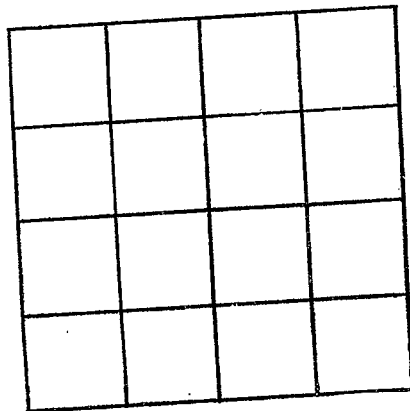

SECTION _____

Please indicate well location X.

ADDITIONAL INFORMATION

If more than one screen, show locations of each on sketch.