

STONE  
G67  
5-6-74

MISSISSIPPI  
BOARD OF WATER COMMISSIONERS  
416 North State Street  
Jackson, Mississippi 39201

CODED

WATER WELL DRILLERS LOG

5-6  
date well completed

1974 Barnell Anderson  
firm name

Stone  
county well located

LANDOWNER:

Larry Briland  
Rt 1 Park  
(mailing address)

description of formations  
encountered

from to

<u>Top Soil</u>	<u>0</u>	<u>4</u>
<u>white clay</u>	<u>4</u>	<u>48</u>
<u>Blue clay</u>	<u>40</u>	<u>65</u>
<u>Coarse Sand</u>	<u>65</u>	<u>85</u>

WELL LOCATION:

sec. 19 T. 3 S. R. 11 E.  
4 miles E of Park  
(distance) (direction) (nearest town)

WELL PURPOSE: HOME  
(home, irrigation, municipal, industrial)

WELL COMPLETION DATA:

- (1) diameter (inches) 2"  
(2) total depth (feet) 85'  
(3) static water level (feet) 64 below above top of ground.  
(4) casing Plastic 80'  
(material) (depth)

CODED

- (size) if telescope see back.  
(5) screen 3" 80'  
(length) (depth to top)  
2" Plastic  
(size) (material)

- (6) pump 1 10  
(HP) (yield gpm)  
Elect  
(type power)

- (7) electric log no  
(yes or no)

(organization running log)

- (8) has well bottom plugged Back with sube


DRILLERS REMARKS:

DRILLERS REMARKS  
MAY 1974

OFFICE RD. OF WATER DIVISION

If well telescopes please sketch and show depths.

GROUND LEVEL

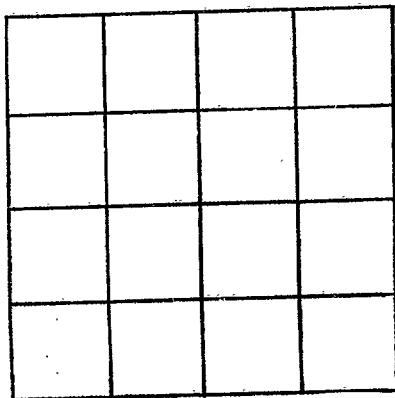

SECTION \_\_\_\_\_

Please indicate well location X.

ADDITIONAL INFORMATION

If more than one screen,  
show locations of each on sketch.