

STONE
G 69
7-30-74

MISSISSIPPI
BOARD OF WATER COMMISSIONERS
416 North State Street
Jackson, Mississippi 39201

CODED

WATER WELL DRILLERS LOG

7-30-74 date well completed
Parnell Anderson Stone firm name
Stone county well located

LANDOWNER:

James Parker
Rt A Peck
(mailing address)

description of formations encountered

from to

Top Soil	0	3
Red Clay	3	26
Fine Sand	26	58
Coarse Sand	58	65
Fine Sand	65	92
Coarse Sand	92	100

WELL LOCATION:

sec. 3 T. 3 S. R. 11 E. W. 6
(distance) miles (direction) of (nearest town)

WELL PURPOSE: HOME
(home, irrigation, municipal, industrial)

WELL COMPLETION DATA:

- (1) diameter (inches) 2"
- (2) total depth (feet) 100'
- (3) static water level (feet) 52' below top of ground.
- (4) casing Plastic, 95'
(material) (depth)
- if telescope see back.
(size)
- (5) screen 5', 95'
(length) (depth to top)
- 2", Plastic
(size) (material)
- (6) pump 1 (HP) 11 (yield gpm)
- Electric
(type power)
- (7) electric log no
(yes or no)

CODED

(organization running log)

(8) how well bottom plugged

Plugged


DRILLERS REMARKS:

RECEIVED

AUG - 2 1974

If well telescopes please sketch and show depths.

GROUND LEVEL

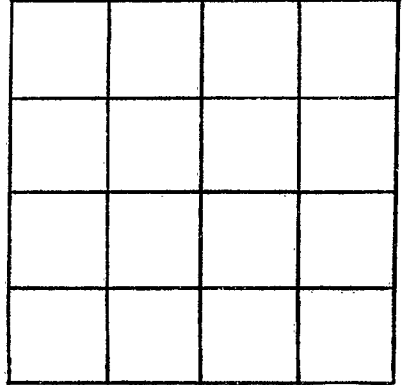

SECTION _____

Please indicate well location X.

ADDITIONAL INFORMATION

If more than one screen,
show locations of each on sketch.