

STONE
G 70
7-16-74

MISSISSIPPI
BOARD OF WATER COMMISSIONERS
416 North State Street
Jackson, Mississippi 39201

CODED

WATER WELL DRILLERS LOG

7-16 1974 Parnell Anderson Stone
date well completed firm name county well located

LANDOWNER: International Paper
(mailing address)

description of formations encountered	from	to
<u>Top Soil</u>	<u>0</u>	<u>4</u>
<u>Blue clay</u>	<u>4</u>	<u>45</u>
<u>Coarse Sand</u>	<u>45</u>	<u>65</u>

WELL LOCATION:
sec. 23 T 3 N R 11 E
S W
6 miles E of Perk
(distance) (direction) (nearest town)

WELL PURPOSE: camp
(home, irrigation, municipal, industrial)

WELL COMPLETION DATA:

(1) diameter (inches) 2 1/2"

(2) total depth (feet) 65'

(3) static water level (feet) 18' below top of ground. above

(4) casing Plastic 60'
(material) (depth)

_____ if telescope see back.
(size)

(5) screen 5', 60'
(length) (depth to top)

2" Plastic
(size) (material)

(6) pump 1 11
(HP) (yield gpm)


E. West
(type power)

(7) electric log no
(yes or no)

_____ (organization running log)

(8) how well bottom plugged plugged

CODED

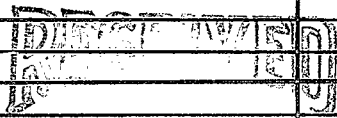


DRILLERS REMARKS:

AUG - 2 1974

If well telescopes please sketch and show depths.

GROUND LEVEL

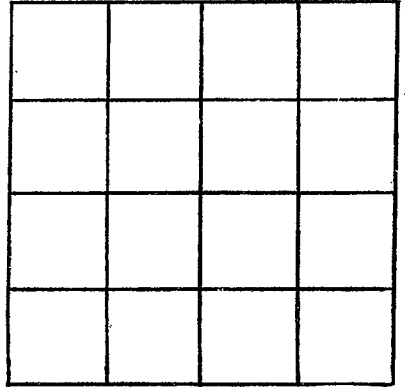

SECTION _____

Please indicate well location X.

ADDITIONAL INFORMATION

If more than one screen,
show locations of each on sketch.