

STONE
G 71
8-1-74

MISSISSIPPI
BOARD OF WATER COMMISSIONERS
416 North State Street
Jackson, Mississippi 39201

CODED

WATER WELL DRILLERS LOG

8-1-74 date well completed
Farnell Anderson Stone firm name
Stone county well located

LANDOWNER:
Truman V. Banks
Rt 1 Parklinton
(mailing address)

description of formations encountered	from	to
Top Soil	0	4
Red clay	4	16
Flint Sand	16	50
Coarse Sand	50	65

WELL LOCATION:
sec. 4 T. 3 S. R. 11 W.
2 miles SE of Weymouth
(distance) (direction) (nearest town)

WELL PURPOSE: HOME
(home, irrigation, municipal, industrial)

WELL COMPLETION DATA:

(1) diameter (inches): 2"

(2) total depth (feet): 65'

(3) static water level (feet): 32' below top of ground.

(4) casing (material): Plastic (depth): 60'

(size) If telescope see back.

(5) screen 5' (length), 60' (depth to top)
2" (size), Plastic (material)

(6) pump 1 (HP), 10 (yield gpm)
Elect (type power)

(7) electric log No (yes or no)

(organization running log)

(8) how well bottom plugged
Barbed wire

DRILLERS REMARKS:


RECEIVED
SEP - 5 1974

MISS. BD. OF WATER

If well telescopes please sketch and show depths.

sect
33 / R11 W / T 4 S

GROUND LEVEL

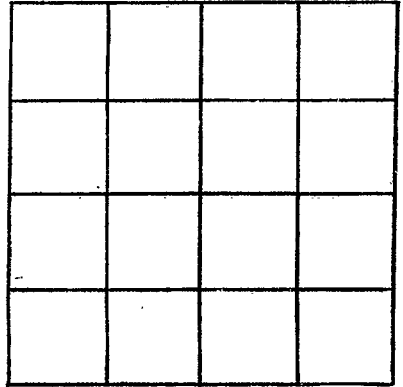

SECTION _____

Please indicate well location X.

ADDITIONAL INFORMATION

Lined area for additional information, consisting of approximately 20 horizontal lines.

If more than one screen, show locations of each on sketch.