

STONE
672
9/16/74

MISSISSIPPI
BOARD OF WATER COMMISSIONERS
416 North State Street
Jackson, Mississippi 39201

CODED

WATER WELL DRILLERS LOG

9-16 1974 Pennell Anderson Stone
date well completed firm name county well located

LANDOWNER:
John W Hittinton
Rt 1 Perkinston
(mailing address)

description of fomations encountered	from	to
Top Soil	0	4
white clay	4	45
Blue Clay	45	160
white Clay	160	189
Thin Sand	189	215
Coarse Sand	215	235

WELL LOCATION:
sec. 6 T. 3 S. R. 11 W.
5 miles SE of Wlog
(distance) (direction) (nearest town)

WELL PURPOSE: HOME
(home, irrigation, municipal, industrial)

- WELL COMPLETION DATA:
- (1) diameter (inches) 2"
 - (2) total depth (feet) 235'
 - (3) static water level (feet) 68' below top of ground.
 - (4) casing Plastic, 228'
(material) (depth)
 - _____ if telescope see back.
(size)
 - (5) screen 5', 228'
(length) (depth to top)
 - 2", Plastic
(size) (material)
 - (6) pump 1 8
(HP) (yield gpm)
 - Elect
(type power)
 - (7) electric log no
(yes or no)
 - _____ (organization running log)
 - (8) how well bottom plugged Back wash valve


CODED

RECEIVED
OCT 10 1974

DRILLERS REMARKS:

If well telescopes please sketch and show depths.

GROUND LEVEL

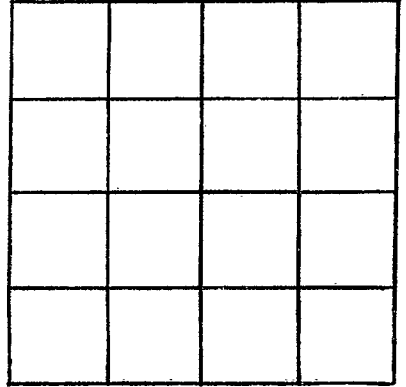

SECTION _____

Please indicate well location X.

ADDITIONAL INFORMATION

If more than one screen,
show locations of each on sketch.