

STONE
G 73
10/23/74

MISSISSIPPI
BOARD OF WATER COMMISSIONERS
416 North State Street
Jackson, Mississippi 39201

CODED

WATER WELL DRILLERS LOG

10-23 1974 Parnell Anderson Stone
date well completed firm name county well located

LANDOWNER:
Bill Smith

(mailing address)

description of formations encountered	from	to
<u>Top Soil</u>	<u>0</u>	<u>3</u>
<u>Sandy Clay</u>	<u>3</u>	<u>24</u>
<u>Fine Sand</u>	<u>24</u>	<u>35</u>
<u>Coarse Sand</u>	<u>35</u>	<u>65</u>

WELL LOCATION:
sec. 4 T. 3 S. R. 11 E.
6 miles SE of Wiggins
(distance) (direction) (nearest town)

WELL PURPOSE: HOME
(home, irrigation, municipal, industrial)

WELL COMPLETION DATA:

(1) diameter (inches) 2"

(2) total depth (feet) 65'

(3) static water level (feet) 40 below ~~above~~ top of ground.

(4) casing Plastic, 60',
(material) (depth)
(size) if telescope see back.

(5) screen 5", 60'
(length) (depth to top)
2", Plastic
(size) (material)

(6) pump 1 9
(HP) (yield gpm)
Elect
(type power)

(7) electric log no
(yes or no)

(organization running log)

(8) how well bottom plugged Plugged


DRILLERS REMARKS:

CODED

RECEIVED
NOV 12 1974

If well telescopes please sketch and show depths.

GROUND LEVEL

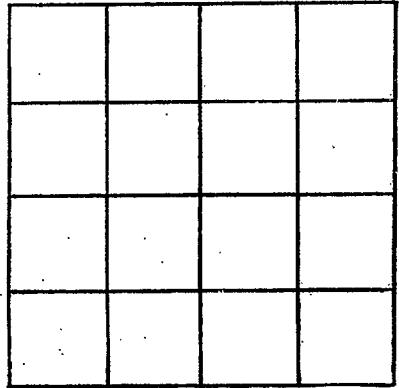

SECTION _____

Please indicate well location X.

ADDITIONAL INFORMATION

If more than one screen, show locations of each on sketch.