

STONE  
G 74  
1-15-75

MISSISSIPPI  
BOARD OF WATER COMMISSIONERS  
416 North State Street  
Jackson, Mississippi 39201

CODED

WATER WELL DRILLERS LOG

1-15-75 date well completed  
1975 Barmell Anderson firm name  
Stone county well located

LANDOWNER:  
Otis Hatten  
(mailing address)

WELL LOCATION:  
sec. 1 T 3 S R 11 E  
6 miles E of Wiggins  
(distance) (direction) (nearest town)

WELL PURPOSE: HOME  
(home, irrigation, municipal, industrial)

- WELL COMPLETION DATA:
- (1) diameter (inches) 3"
  - (2) total depth (feet) 105'
  - (3) static water level (feet) 42' below top of ground.
  - (4) casing Plastic, 100'  
(material) (depth)  
(size) if telescope see back.
  - (5) screen 5' 100'  
(length) (depth to top)  
2" Plastic  
(size) (material)
  - (6) pump 1 10  
(HP) (yield gpm)  
E lect  
(type power)
  - (7) electric log no  
(yes or no)
  - (organization running log)
  - (8) how well bottom plugged Back with valve


DRILLERS REMARKS:

description of formations encountered	from	to
Top Soil	0	4
Red Sand	4	18
Pink Clay	18	36
Hard Sand	36	74
Coarse Sand	74	103

RECEIVED  
FEB 3 1975  
MISS. BD. OF WATER COMMISSIONERS

If well telescopes please sketch and show depths.

GROUND LEVEL

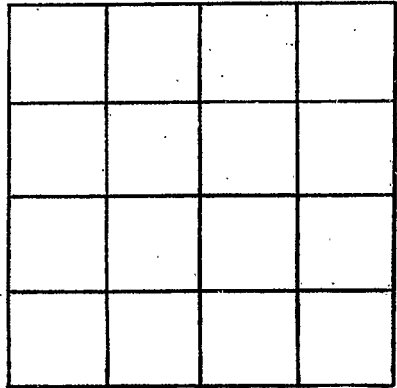

SECTION \_\_\_\_\_

Please indicate well location X.

ADDITIONAL INFORMATION

If more than one screen, show locations of each on sketch.