

STONE
G 75
3-19-75

MISSISSIPPI
BOARD OF WATER COMMISSIONERS
416 North State Street
Jackson, Mississippi 39201

CODED

WATER WELL DRILLERS LOG

3-19 date well completed
25 Pennell Anderson firm name
Stone county well located

LANDOWNER:	description of formations encountered	from	to
Tobby Morris	Top Soil	0	3
(mailing address)	Fine Sand	4	20
WELL LOCATION:	Coarse Sand	30	105
sec. 7 T. 3 N. R. 11 E. S W			
2 1/2 miles S of Bogalusa			
(distance) (direction) (nearest town)			
WELL PURPOSE: HOME			
(home, irrigation, municipal, industrial)			
WELL COMPLETION DATA:			
(1) diameter (inches) 5"			
(2) total depth (feet) 165'			
(3) static water level (feet) 38' below top of ground			
(4) casing Plastic 100'			
(material) (depth)			
(size) if telescope see back.			
(5) screen 5' 100'			
(length) (depth to top)			
5" Plastic			
(size) (material)			
(6) pump 1 12			
(HP) (yield gpm)			
Elect			
(type power)			
(7) electric log no.			
(yes or no)			
(organization running log)			
(8) how well bottom plugged			
Plugged			
DRILLERS REMARKS:			


CODED

RECEIVED
NOV 31 1975

MISS. RD. OF WATER

If well telescopes please sketch and show depths.

GROUND LEVEL

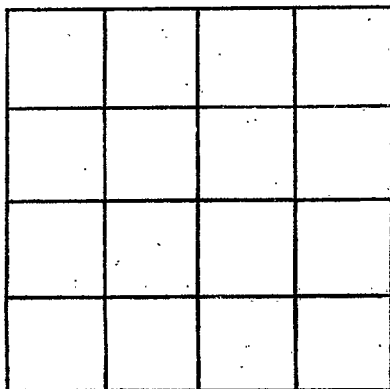

SECTION _____

Please indicate well location X.

ADDITIONAL INFORMATION

If more than one screen, show locations of each on sketch.