

G 76
 Stone
 5/5/75

MISSISSIPPI
 BOARD OF WATER COMMISSIONERS
 416 North State Street
 Jackson, Mississippi 39201

CODED 2F

WATER WELL DRILLERS LOG

5-5 1975 Parrell Anderson Stone
 date well completed firm name county well located

LANDOWNER:
Betty Danning
 (mailing address)

description of formations encountered	from	to
<u>Top Soil</u>	<u>0</u>	<u>4</u>
<u>Red Clay</u>	<u>4</u>	<u>28</u>
<u>Fin Sand</u>	<u>28</u>	<u>105</u>
<u>Coarse Sand</u>	<u>105</u>	<u>125</u>

WELL LOCATION:
 sec. 2 T 3 S R. 11 W
6 miles E of W. Logg
 (distance) (direction) (nearest town)


WELL PURPOSE: HOME
 (home, irrigation, municipal, industrial)

- WELL COMPLETION DATA:
- (1) diameter (inches) 2"
 - (2) total depth (feet) 125'
 - (3) static water level (feet) 39' below top of ground
 - (4) casing Plastic 120'
 (material) (depth)
 (size) If telescope see back.
 - (5) screen 5' 120'
 (length) (depth to top)
3" Plastic
 (size) (material)
 - (6) pump 1 13
 (HP) (yield gpm)
Elect
 (type power)
 - (7) electric log no.
 (yes or no)

(organization running log)


(8) how well bottom plugged
Back with concrete

DRILLERS REMARKS:

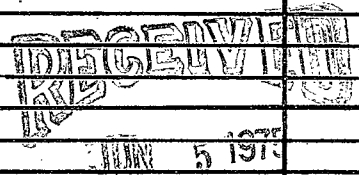

If well telescopes please sketch and show depths.

GROUND LEVEL

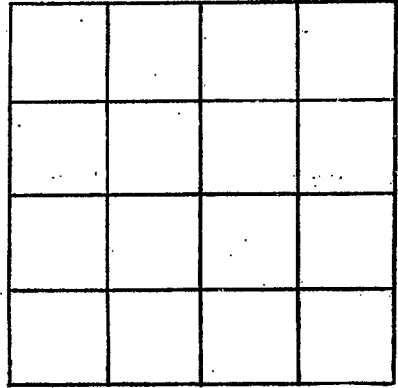

SECTION _____

Please indicate well location X.

ADDITIONAL INFORMATION

Lined area for providing additional information, consisting of approximately 20 horizontal lines.

If more than one screen, show locations of each on sketch.