

Stone
 G 77
 6-8-75

MISSISSIPPI
 BOARD OF WATER COMMISSIONERS
 416 North State Street
 Jackson, Mississippi 39201

WATER WELL DRILLERS LOG

CODED

6-78 1975 Parrell Anderson Stone
 date well completed firm name county well located

LANDOWNER:
Liberty Hill Church
 (mailing address)

description of formations encountered	from	to
<u>Top Soil</u>	<u>0</u>	<u>5</u>
<u>Fine Sand</u>	<u>5</u>	<u>18</u>
<u>White Clay</u>	<u>18</u>	<u>34</u>
<u>Fine Sand</u>	<u>34</u>	<u>68</u>
<u>Coarse Sand</u>	<u>68</u>	<u>85</u>

WELL LOCATION:
 sec. 5 T. 3 N. R. 11 E. 13Q
5 miles SE of Wiggins
 (distance) (direction) (nearest town)

WELL PURPOSE: MUNICIPAL
 (home, irrigation, municipal, industrial)

WELL COMPLETION DATA:

(1) diameter (inches) 2"

(2) total depth (feet) 85'

(3) static water level (feet) 40' below top of ground. above

(4) casing Plastic, 80'
 (material) (depth)

(size) If telescope see back.

(5) screen 5', 80'
 (length) (depth to top)

5", Plastic
 (size) (material)

(6) pump 1, 9
 (HP) (yield gpm)


Electric
 (type power)

(7) electric log No
 (yes or no)

(organization running log)

(8) how well bottom plugged Backwash valve

CODED

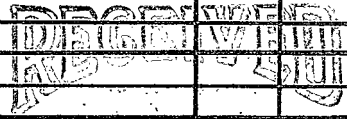


JUN - 2 1975

DRILLERS REMARKS:

If well telescopes please sketch and show depths.

GROUND LEVEL

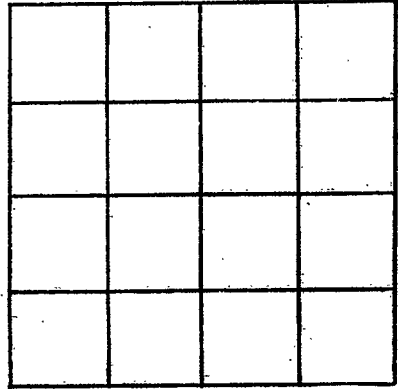

SECTION _____

Please indicate well location X.

ADDITIONAL INFORMATION

If more than one screen,
show locations of each on sketch.