

Stone
 G 78
 6-13-75

MISSISSIPPI
 BOARD OF WATER COMMISSIONERS
 416 North State Street
 Jackson, Mississippi 39201

CODED

WATER WELL DRILLERS LOG

6-13 1975 *Donnell Anderson* *L. Long*
 date well completed firm name county well located

LANDOWNER:
Griffen Bond
 (mailing address)

description of formations encountered	from	to
<i>Top Soil</i>	<i>0</i>	<i>4</i>
<i>Pink Clay</i>	<i>4</i>	<i>30</i>
<i>Coarse Sand</i>	<i>30</i>	<i>35</i>

WELL LOCATION:
 sec. *3* T. *3* N. R. *11* E. *13Q*
5 miles *E* of *W. Lehigh*
 (distance) (direction) (nearest town)

WELL PURPOSE: *HOME*
 (home, irrigation, municipal, industrial)

CODED

- WELL COMPLETION DATA:
- (1) diameter (inches) *3"*
 - (2) total depth (feet) *35'*
 - (3) static water level (feet) *14'* above top of ground.
 - (4) casing *Plastic*, *50'*
 (material) (depth)
 (size) if telescope see back.
 - (5) screen *5"* *50'*
 (length) (depth to top)
5" *Plastic*
 (size) (material)
 - (6) pump *1* *12*
 (HP) (yield gpm)
Elect
 (type power)
 - (7) electric log *no*
 (yes or no)
- (organization running log)


(8) how well bottom plugged
Plugged

DRILLERS REMARKS:

RECEIVED
 APR 2 1975

If well telescopes please sketch and show depths.

GROUND LEVEL

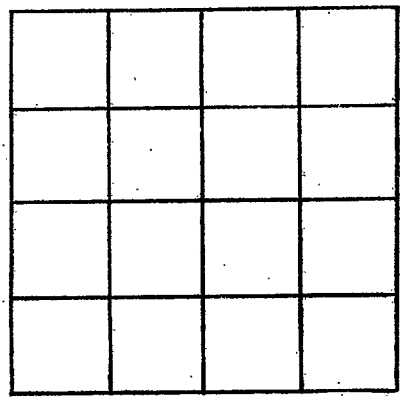

SECTION _____

Please indicate well location X.

ADDITIONAL INFORMATION

A series of horizontal lines for recording additional information.

If more than one screen, show locations of each on sketch.