

STONE
 G-80
 1-19-80

MISSISSIPPI
 BOARD OF WATER COMMISSIONERS
 416 North State Street
 Jackson, Mississippi 39201

CODED

WATER WELL DRILLERS LOG

1-19-80 date well completed 1980 Braden Pump & Well firm name Stone county well located

LANDOWNER:
 International Paper Co
 Wiggins, MS 39577

description of formations encountered	from	to
Clay	0	50
Sand	50	100
Clay	100	180
Sand	180	360

(mailing address)

WELL LOCATION:
 sec. 6 T. 3 S R. 11 W.
 2 miles S of Wiggins
 (distance) (direction) (nearest town)

~~CODED~~

WELL PURPOSE: industrial
 (home, irrigation, municipal, industrial)

- WELL COMPLETION DATA:
- (1) diameter (inches) 4"
 - (2) total depth (feet) 360'
 - (3) static water level (feet) 40' below top of ground.
 - (4) casing PVC total
 (material) (depth)
 4" (size) If telescope see back.
 - (5) screen 20' 340'
 (length) (depth to top)
 4" (size) PVC under liner
 - (6) pump turbine 5 HP 30 (material)
 (HP) (yield gpm)
 230 (type power)
 - (7) electric log no
 (yes or no)
- (organization running log)

DEPT. OF NATURAL RESOURCES
 BUREAU OF LAND & WATER RESOURCES


MAY 20 1980

RECEIVED

DRILLERS REMARKS:
 20' tail pipe

If well telescopes please sketch and show depths.

GROUND LEVEL

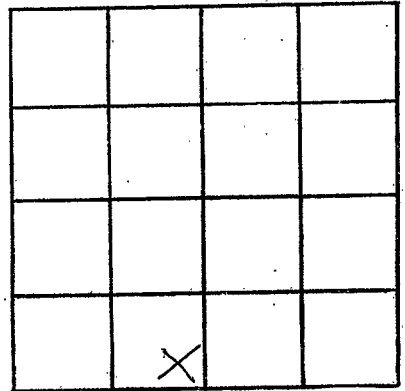

SECTION 6

Please indicate well location X.

ADDITIONAL INFORMATION

If more than one screen,
show locations of each on sketch.