

MISSISSIPPI DEPARTMENT OF NATURAL RESOURCES
 Bureau of Land and Water Resources
 Southport Mall
 P.O. Box 10631
 Jackson, Mississippi 39209
WATER WELL DRILLERS LOG

CODED

Stone
 G 81
 2-13-84

2-13 1984 McGill Wells, Inc. STONE
 date well completed firm name county well located

LANDOWNER: Harmer Brock
RT #3, Box 65A
McHenry, MS
 (mailing address)

description of formations encountered	from	to
SAND	0	40
MUD	40	200
SAND & MUD	200	220
SAND	220	280

WELL LOCATION:
 sec. 2 T 3 N R 11 E
 (S) (W)
4 miles EAST of McHenry
 (distance) (direction) (nearest town)

WELL PURPOSE: HOME
 (home, irrigation, municipal, industrial)

WELL COMPLETION DATA:

(1) diameter (inches) 4"

(2) total depth (feet) 280

(3) static water level (feet) 160 below above top of ground.

(4) casing 40 PVC, 270'
 (material) (depth)
 (size) If telescope see back.

(5) screen 10', 270'
 (length) (depth to top)
4", 80 PVC, 6 SLOT
 (size) (material)

(6) pump 1 SUB, 12
 (HP) (yield gpm)
Electric
 (type power)

(7) electric log NO
 (yes or no)
 (organization running log)

(8) how well bottom plugged SAND SEAL

DRILLERS REMARKS:


DEPT. OF NATURAL RESOURCES
 BUREAU OF LAND & WATER RESOURCES

MAR - 6 1984

RECEIVED

If well telescopes please sketch and show depths.

GROUND LEVEL

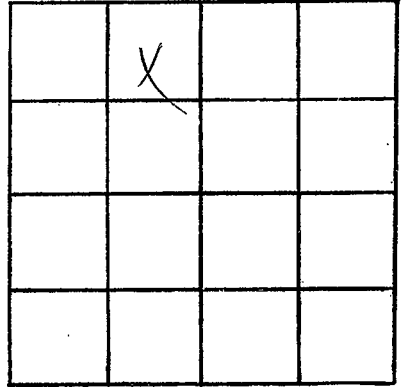

SECTION 7

Please indicate well location X.

ADDITIONAL INFORMATION

If more than one screen,
show locations of each on sketch.