

MISSISSIPPI DEPARTMENT OF NATURAL RESOURCES

Bureau of Land and Water Resources

Southport Mall

P.O. Box 10631

Jackson, Mississippi 39209

WATER WELL DRILLERS LOG

Stone Co.
G82
5-3-84

CODE

5-3-84
date well completed

1984 Frank Price
firm name

Stone
county well located

LANDOWNER:	description of formations encountered	from	to
Ten Mile Church	Top Soil	0	2
(mailing address)	Clay	2	65
WELL LOCATION:	Course Sand	65	72'
sec. <u>5</u> T. <u>3</u> S. R. <u>11</u> W.			
<u>1</u> miles <u>S</u> of <u>Yalgah</u>			
(distance) (direction) (nearest town)			
WELL PURPOSE: <u>HOME</u>			
(home, irrigation, municipal, industrial)			
WELL COMPLETION DATA:			
(1) diameter (inches) <u>2</u>			
(2) total depth (feet) <u>72'</u>			
(3) static water level (feet) <u>50'</u> below top of ground.			
(4) casing <u>PVC</u> , <u>67'</u>			
(material) (depth)			
(size) if telescope see back.			
(5) screen <u>5"</u> , <u>67'</u>			
(length) (depth to top)			
<u>2</u> , <u>PVC</u>			
(size) (material)			
(6) pump <u>1</u> , <u>8</u>			
(HP) (yield gpm)			
<u>Elect</u>			
(type power)			
(7) electric log <u>no</u>			
(yes or no)			
(organization running log)			
(8) how well bottom plugged <u>B.W.V.</u>			
DRILLERS REMARKS:			

CODED


DEPT. OF NATURAL RESOURCES
BUREAU OF LAND & WATER RESOURCES

JUL 12 1984

RECEIVED

If well telescopes please sketch and show depths.

GROUND LEVEL

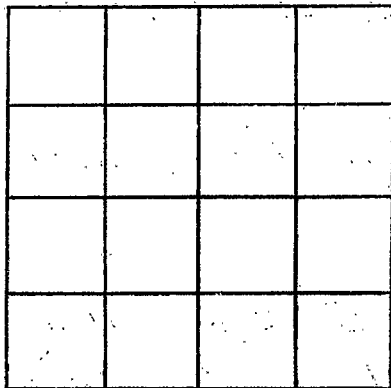

SECTION _____

Please indicate well location X.

ADDITIONAL INFORMATION

If more than one screen, show locations of each on sketch.