

MISSISSIPPI DEPARTMENT OF NATURAL RESOURCES

Bureau of Land and Water Resources

Southport Mall

P.O. Box 10631

CODED

Jackson, Mississippi 39209

WATER WELL DRILLERS LOG

STONE

G84

10-30  
date well completed

1984 Frank Price  
firm name

Stone  
county well located

LANDOWNER:

Mrs I. P. Spriss

(mailing address)

WELL LOCATION:

sec 4 T. 3 R. 11  
2 miles S of Sinda  
(distance) (direction) (nearest town)

WELL PURPOSE: HOME  
(home, irrigation, municipal, industrial)

WELL COMPLETION DATA:

- (1) diameter (inches) 2"
- (2) total depth (feet) 90'
- (3) static water level (feet) 70' below top of ground
- (4) casing PVC, 85' (material) (depth)
- (5) screen 3' 85' (length) (depth to top)
- 2" PVC (size) (material)
- (6) pump 1/2 (HP) 8 (yield gpm)
- Elect (type power)
- (7) electric log no (yes or no)

(organization running log)

(8) how well bottom plugged

BWV

DRILLERS REMARKS:

description of formations encountered

from to

Top Soil	0	3
Clay	3	20
Line Sand	20	80
Meddians Sand	80	90'


CODED

DEPT. OF NATURAL RESOURCES  
BUREAU OF LAND & WATER RESOURCES

NOV 5 1984  
RECEIVED

If well telescopes please  
sketch and show depths.

GROUND LEVEL

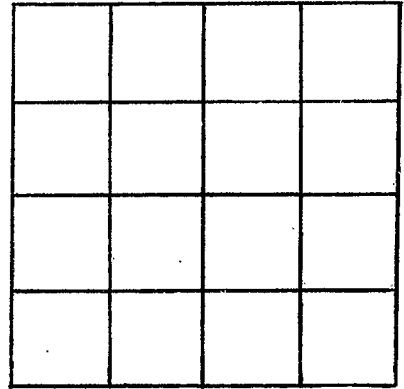

SECTION \_\_\_\_\_

Please indicate well location X.

ADDITIONAL INFORMATION

If more than one screen,  
show locations of each on sketch.