

MISSISSIPPI DEPARTMENT OF NATURAL RESOURCES

Bureau of Land and Water Resources

Southport Mall

P.O. Box 10631

Jackson, Mississippi 39209

CODED

WATER WELL DRILLERS LOG

STONE

G 85

9-18-84
date well completed

Frank Price
firm name

Stone
county well located

LANDOWNER:

John Lewis

(mailing address)

WELL LOCATION:

sec. 19 T. 3 N. R. 11 E.
1/2 miles SE of Park
(distance) (direction) (nearest town)

WELL PURPOSE: HOME
(home, irrigation, municipal, industrial)

WELL COMPLETION DATA:

- (1) diameter (inches) 2"
- (2) total depth (feet) 128'
- (3) static water level (feet) 50' below top of ground.
- (4) casing PVC, 123'
(material) (depth)
(size) If telescope see back.
- (5) screen 5', 123'
(length) (depth to top)
2" PVC
(size) (material)
- (6) pump 1 (HP), 10 (yield gpm)
E lect
(type power)
- (7) electric log NO
(yes or no)

(organization running log)

(8) how well bottom plugged
B W V

description of formations encountered

from to

Top Soil	0	3
Clay	3	98
fine sand	98	118
Medium Sand	118	123

CODED


DEPT. OF NATURAL RESOURCES
BUREAU OF LAND & WATER RESOURCES

NOV 5 1984
RECEIVED

DRILLERS REMARKS:

If well telescopes please
sketch and show depths.

GROUND LEVEL

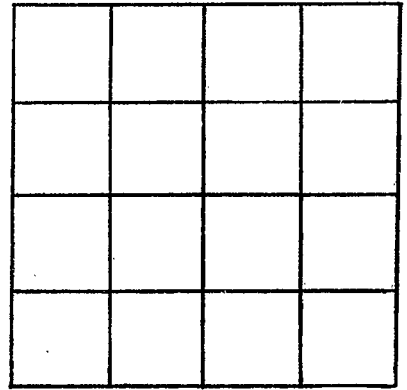

SECTION _____

Please indicate well location X.

ADDITIONAL INFORMATION

If more than one screen,
show locations of each on sketch.