	- State V	Vell Report	·
County: Stone		Part 1	For Office Use Only
	Mississippi Departmen	Mississippi Department of Environmental Quality	
Permit #:		and Water Resources Box 10631	Well #: 6 - 105
Driller: Michaels, Havard		MS 39289-0631	L. S. Elevation:
Date drilling completed: 10-29-05	(601)961-5210	
		54-6938 (fax)	E-log #:
State Law requires that this rep	port be prepared by the	driller in detail and filed w	ith the Department with
30 days of completion of drillin		Well	Location
Well Owner Information		Well Location	
Owner Name Terry Bird		Latitude: <u>30 ° 48 ' 994</u> " Longitude: <u>89 ° 02 '</u>	
Mailing Address: 1123 King Bee Road		Method of Lat/Long (circle one): Conventional Survey,	
•		USGS guad. Hand-held	GPS Survey-grade GPS
		NW 14 SE 14 Sec 1	
Perkingston MS 39573			
City St	tate Zip Code	Distance Direction	Nearest Town
Telephone No. (601) 538-343	ባ		u big bevel
	Well	Data	
Purpose of Well (circle one) Home In	dustrial Public Supely	Irrigation Fish Culture	Other:
		6	
Date well drilling started IA . 79 . A	C Data :		
Date wen unning started. 10 - 27-0		well drilling completed: <u>\0 -</u> .	14-0.)
If flowing, method of flow regulation: Va			
If flowing, method of flow regulation: Va	alve Other (lescribe)	······
If flowing, method of flow regulation: Va Static Water Level:feet a	alve Other (a	lescribe) land surface Date measured:	10-29-05
If flowing, method of flow regulation: Va Static Water Level:feet a Method of Measurement (circle one)	alve Other (above or below (circle one) steel tape electric tape	describe) land surface Date measured:	10-29-05
If flowing, method of flow regulation: Va Static Water Level:feet a	alve Other (above or below (circle one) steel tape electric tape	describe) land surface Date measured:	10-29-05
If flowing, method of flow regulation: Va Static Water Level:feet a Method of Measurement (circle one)	alve Other (above or below (circle one) steel tape electric tape	lescribe) land surface Date measured: arguine other: Well grouted to a depth of	10-29-05
If flowing, method of flow regulation: Va Static Water Level: feet a Method of Measurement (circle one) Hole depth: Well de Type of grout (circle one): Cement	alve Other (d above or below (circle one) steel tape electric tape epth: <u>IO (</u> Bentonite	lescribe) land surface Date measured: arce other: Well grouted to a depth of	10-29-05 18 feet
If flowing, method of flow regulation: Va Static Water Level:	alve Other (a above or below (circle one) steel tape electric tape epth: <u>101</u> Bentonite <u>Mirc</u> sing diameter: <u>4</u>	lescribe) land surface Date measured: air other: Well grouted to a depth of 	10-29-05 18 feet PUC 540
If flowing, method of flow regulation: Va Static Water Level:	alve Other (a above or below (circle one) steel tape electric tape epth: IO Bentonite Elimeter: Y reen diameter: Y	lescribe) land surface Date measured: well grouted to a depth of inches Type of casing: inches Type of screen:	10-29-05 18 feet PUC S40 ,010 WOP PUC
If flowing, method of flow regulation: Va Static Water Level: feet a Method of Measurement (circle one) = s Hole depth: Well de Type of grout (circle one): Cement Casing length: feet Cas	alve Other (a above or below (circle one) steel tape electric tape epth: IO Bentonite Elimeter: Y reen diameter: Y	lescribe) land surface Date measured: well grouted to a depth of inches Type of casing: inches Type of screen:	10-29-05 18 feet PUC S40 ,010 WOP PUC
If flowing, method of flow regulation: Va Static Water Level:	alve Other (a above or below (circle one) steel tape electric tape epth: Bentonite ing diameter: reen diameter: Setting depth: From	describe) land surface Date measured: air other: Well grouted to a depth of inches Type of casing:	10-29-05 18 feet PUC 540 ,010 WOP PUC 01 feet
If flowing, method of flow regulation: Va Static Water Level:	alve Other (d above or below (circle one) steel tape electric tape epth: Bentonite Mine ing diameter: reen diameter: Setting depth: From Setting depth: From	land surface Date measured: air other: Well grouted to a depth of inches Type of casing: inches Type of screen:	10-29-05 18 feet PJC 540 ,010 WOP PJC 01 feet hole Natural Development
If flowing, method of flow regulation: Va Static Water Level: feet a Method of Measurement (circle one) = = Hole depth: Well de Type of grout (circle one): Cement Casing length: feet Cas Screen length: feet Scr Screen slot size: feet Scr Type of completion (circle all applicable)	alve Other (d above or below (circle one) steel tape electric tape epth: D Bentonite Bentonite ing diameter: setting depth: From Setting depth: From): Gravel packet Unde Other (describe):	describe) land surface Date measured: arture other: Well grouted to a depth of	10-29-05 <u>18</u> feet <u>PJC 540</u> <u>010 WoP PJC</u> <u>010 feet</u> hole Natural Development
If flowing, method of flow regulation: Va Static Water Level:	alve Other (d above or below (circle one) steel tape electric tape epth: D Bentonite Bentonite ing diameter: setting depth: From Setting depth: From): Gravel packet Unde Other (describe):	describe) land surface Date measured: arture other: Well grouted to a depth of	10-29-05 <u>18</u> feet <u>PJC 540</u> <u>010 WoP PJC</u> <u>010 feet</u> hole Natural Development
If flowing, method of flow regulation: Va Static Water Level: 28 feet a Method of Measurement (circle one) s Hole depth: 101 Well de Type of grout (circle one): Cement Casing length: 91 feet Cas Screen length: 10 feet Scr Screen slot size: $.010$ inches Type of completion (circle all applicable)	alve Other (d above or below (circle one) steel tape electric tape epth: ID Bentonite Bentonite ing diameter: 4 reen diameter: 4 setting depth: From Setting depth: From (): fravel packed Under Other (describe):	describe) land surface Date measured: arture other: Well grouted to a depth of inches Type of casing: inches Type of screen: inches Telescoped Generation Open State Open State Open	10-29-05 18 feet PJC 540 ,010 WOP PJC DI feet hole Natural Development reen, describe on back of pa
If flowing, method of flow regulation: Va Static Water Level:	alve Other (above or below (circle one) steel tape electric tape epth: IO Bentonite Miss sing diameter: Y reen diameter: Y Setting depth: From Setting depth: From Setting depth: From Other (describe): feet. If te	land surface Date measured: land surface Date measured: well grouted to a depth of Well grouted to a depth of	10-29-05 18 feet PUC 540 010 100 P PUC 010 100 P PUC 010 100 P PUC 010 100 P PUC 10 100 P PUC
If flowing, method of flow regulation: Va Static Water Level:	alve Other (d above or below (circle one) steel tape electric tape epth: Bentonite Mine ing diameter: reen diameter: Setting depth: From Setting depth: From Setting depth: From Other (describe): feet. If te men Electric Gamma Ray	land surface Date measured: land surface Date measured: attrace other: Well grouted to a depth of inches Type of casing: inches Type of screen: inches Type of screen: inches Type of screen: inches Type of screen: ifeet to ifeet to elescoped or more than one screen: ifeet to ifeet to ifeet to ifeet to ifeet to ifeet to ifeet to ifeet to ifeet to	10-29-05 18 feet PJC 540 ,010 WOP PJC D1 feet hole Natural Development een, describe on back of pa Other: requirements of the Missis
If flowing, method of flow regulation: Va Static Water Level:feet a Method of Measurement (circle one) = = Hole depth: Well de Type of grout (circle one): Cement Casing length: feet Cas Screen length: feet Scr Screen slot size: feet Scr Screen slot size: feet Scr Type of completion (circle all applicable) Top of lap pipe or reduction in casing: Logs run (circle all applicable): foog run Name of organization running log(s):	alve Other (d above or below (circle one) steel tape electric tape epth: Bentonite Mine ing diameter: reen diameter: Setting depth: From Setting depth: From Setting depth: From Other (describe): feet. If te men Electric Gamma Ray	land surface Date measured: land surface Date measured: attrace other: Well grouted to a depth of inches Type of casing: inches Type of screen: inches Type of screen: inches Type of screen: inches Type of screen: ifeet to ifeet to elescoped or more than one screen: ifeet to ifeet to ifeet to ifeet to ifeet to ifeet to ifeet to ifeet to ifeet to	10-29-05 18 feet PJC 540 ,010 WOP PJC D1 feet hole Natural Development een, describe on back of pa Other: requirements of the Missis
If flowing, method of flow regulation: Va Static Water Level:	alve Other (above or below (circle one) steel tape electric tape epth: Bentonite ing diameter: Setting depth: From Setting depth: From Setting depth: From Setting depth: From Other (describe): feet. If te Describe in and/or the Mississippi Description	land surface Date measured: land surface Date measured: attrace other: Well grouted to a depth of inches Type of casing: inches Type of screen: inches Type of screen: inches Type of screen: inches Type of screen: ifeet to ifeet to elescoped or more than one screen: ifeet to ifeet to ifeet to ifeet to ifeet to ifeet to ifeet to ifeet to ifeet to	10-29-05 18 feet PJC S40 ,010 WOP PJC D1 feet hole Natural Development een, describe on back of pa Other: requirements of the Missis
If flowing, method of flow regulation: Va Static Water Level:	alve Other (d above or below (circle one) steel tape electric tape epth: Bentonite Mine ing diameter: reen diameter: Setting depth: From Setting depth: From Setting depth: From Other (describe): feet. If te men Electric Gamma Ray	Jescribe) land surface Date measured: air face other: Well grouted to a depth of	10-29-05 18 feet PJC S40 ,010 WOP PJC D1 feet hole Natural Development een, describe on back of pa Other: requirements of the Missis

BETENEN (FESTAR BY CLWR

G 105


If well telescopes please sketch below and show depths.

Ground Level

Description of Formations Encountered	From	То
Topsand	0	8
5:14	8	18
Clay	18	23
5:14	23	32
Sand (red)	52	64
<u>silt</u>	64	72
Sand (and)	12	101
· · · · · · · · · · · · · · · · · · ·		
	_	
		\vdash
·····		
· · · · · · · · · · · · · · · · · · ·		
······································		
·····		
· · · · · · · · · · · · · · · · · · ·		
	I	

If more than one screen, show location of each on sketch

Sketch the property layout and include the following: 1) the well location; 2) any permanent structures on the property that may aid in locating the well; 3) any roads, power lines, or other items that may aid in locating the property and the well; 4) indicate direction.

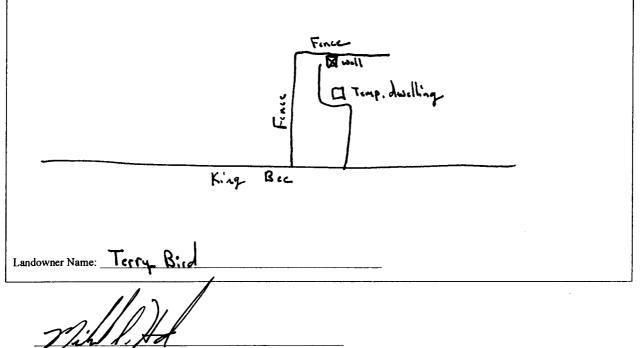

Signature of Water Well Contractor

PECENTO BELEMAN PYLOLVAR

	STATE WI	ELL REPORT		
County: Stone Permit #: Driller: M.; cl.als. Hward Date completed: 10 - 29-05	Part 2 Pump Installer's Completion Report Mississispi Department of Environmental Quality Office of Land and Water Resources P.O. Box 10631 Jackson, MS 39289-0631 (601)961-5210 (601)354-6938 (fax)		For Office Use Only: Aquifer: Well #.G 10.5 Elevation:	
This report should be prepared by the	pump installer in deta	ail and filed with the Departme	ent within 30 days of the	
installation of pump. Well Owner Informatio	DN	Wel	ll Location	
Owner Name: Torry Bird		Latitude: N30 48. 794 Longitude: W 89 02, 698		
Mailing Address: 11 23 King Bec Rd <u>Recking Ston MS 31573</u> City State Zip Code		Method of Lat/Long (circle one): Conventional Survey, USGS quad, <u>And-held GPS</u> , Survey-grade GPS ¹ /4 ¹ /4 Sec Twn_ <u>T3S</u> Rng <u>K</u> 11 Distance Direction Nearest Town		
Pump Type Circle one			wer Type ircle one	
Air Lift Jet 🧲	Submersible	Diesel Engine Gasoli	ne Engine Natural Gas	
Bucket Piston	Turbine	Electric Motor Hand	Tractor PTO	
Centrifugal Rotary	Flowing Well	Windmill Other	(specify):	
Other (specify):		Horse Power Rating of Motor	: <u> </u>	
Date Pump Installed: 10-29-05		Setting Depth: 83	feet	
Rated Pump Capacity: 19		Number of Stages:9		
Pump Test Data Date Well Tested: 10 - 29 - 5			easuring Water Level	
Static Water Level (A):Feet B	Below Land Surface	Air Line Electric Mea Other (specify):	-	
Drawdown [(B) - (A)]:Feet B	elow Land Surface	For flowing well, measured sh	nut in head:feet	
	Gallons Per Minute	Well yielded <u>30</u>	GPM with a drawdown of	
Duration of Pump Test (minimum 4 hours):	4.5 hours	feet after _	4,5 hours of pumping	
I HEREBY CERTIFY that the above stateme <u>Michaels</u> Havard Print Name of Pump Installer and License No		of my knowledge.	Istaller	

•