

# STATE WELL REPORT

## Part 1

### Driller's Log

Mississippi Department of Environmental Quality  
Office of Land and Water Resources  
P.O. Box 2309  
Jackson, MS 39225-2309  
(601)961-5210  
(601)360-0535 (fax)

### For Office Use Only:

Well #: G129  
Aquifer: \_\_\_\_\_  
E-Log #: \_\_\_\_\_

County: Stone  
Permit #: \_\_\_\_\_  
Driller: H. Williams  
Date drilling completed: 5/20/15

State Law requires that this report be prepared by the license holder responsible for the work and filed with the Department at the above address within 30 days of completion of drilling of the well or borehole.

Well Owner Information (Landowner if borehole is not for a water well)	Well or Borehole Location
Owner Name: <u>Casey Bond</u>	Latitude: <u>30°48'28"N</u> Longitude: <u>89°3'34.5"W</u>
Mailing Address: <u>36 Bond Rd</u>	Method of Lat/Long (check one): Conventional Survey _____, USGS quad _____, Hand-held GPS <input checked="" type="checkbox"/> , Survey-grade GPS _____
<u>Perkinston</u> MS <u>39573</u>	<u>NW</u> ¼ <u>NE</u> ¼, Sec <u>11</u> T <u>3S</u> R <u>11W</u>
City State Zip Code	<u>5.75</u> Miles <u>SE</u> of <u>Wiggins, MS</u>
Telephone No. <u>(601) 528-4409</u>	(Distance) (Direction) (Nearest Town)

Well / Borehole Data
Date drilling started: <u>5/20</u> Date drilling completed: <u>5/20</u> Hole depth: <u>95</u> Hole diameter: <u>4"</u>
Location of the source of any surface water used for drilling: <u>Municipal</u>
Method of dosing and volume of Chlorine used in drilling and development: <u>N/A</u>
Logs run (circle all applicable): <input checked="" type="checkbox"/> No log run <input type="checkbox"/> Electric <input type="checkbox"/> Gamma Ray <input type="checkbox"/> Density <input type="checkbox"/> Sonic <input type="checkbox"/> Neutron Other: _____
Name of organization running log(s): <u>N/A</u>
Purpose of borehole (circle one): <input checked="" type="radio"/> Water Well <input type="radio"/> Geotechnical/Geological Investigation <input type="radio"/> Ground Source Heat Pump <input type="radio"/> Seismic Survey <input type="radio"/> Other (describe) _____

*If drilling is not related to water well construction, skip the remainder of this block*

Purpose of Well (circle all applicable): <input checked="" type="radio"/> Home <input type="radio"/> Industrial <input type="radio"/> Public Supply <input type="radio"/> Irrigation <input type="radio"/> Fish Culture
Other (describe): _____
If a flowing well, method of flow regulation: Valve <u>N/A</u> Other (describe) _____
Static Water Level: <u>25</u> feet [above or below] land surface Date measured: <u>5/20</u> (circle one)
Method of measurement (circle one): <input checked="" type="radio"/> Steel tape <input type="radio"/> Electric tape <input type="radio"/> Air line Other (describe): _____
Well depth: <u>95</u> Well grouted to a depth of: <u>10</u> feet Type of grout (circle one): <input checked="" type="radio"/> Neat Cement <input type="radio"/> Bentonite <input type="radio"/> Mix
Casing length: <u>85</u> feet Casing diameter: <u>2"</u> inches Type of casing: <u>Sch 40 PVC</u>
Screen length: <u>10</u> feet Screen diameter: <u>2"</u> inches Type of screen: <u>Sch 40 PVC</u>
Screen slot size: <u>0.008</u> inches Setting depth: From <u>85</u> feet to <u>95</u> feet
Type of completion (circle all applicable): Gravel packed <input type="radio"/> Underreamed <input type="radio"/> Open hole <input checked="" type="radio"/> Natural Development
Other (describe): _____
Top of lap pipe or reduction in casing: <u>N/A</u> feet

If telescoped or more than one screen, describe on next page


RECEIVED  
MAY 28 2015  
BY: OLWR

County: Stone  
Permit #: \_\_\_\_\_

**For Office Use Only:**  
Well #: G129

The sketch below only required for water wells

If well telescopes, show depths on sketch.

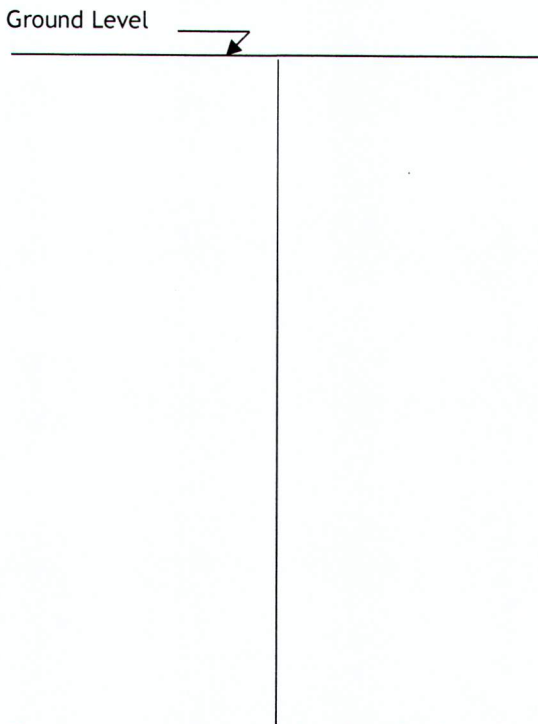


Description of formations encountered must be provided for all wells and boreholes, unless specifically exempted by regulations

Description of Formations Encountered	From (depth)	To (depth)
<u>Lt Br c/sa/sacl</u>	<u>Ground level</u>	<u>25'</u>
<u>Lt Br Sg</u>	<u>25'</u>	<u>95'</u>

If more than one screen, show location of each on sketch

- Sketch the property layout and include the following:
- 1) the well location
  - 2) any permanent structures on the property that may aid in locating the well
  - 3) any roads, power lines, or other items that may aid in locating the property and the well
  - 4) north arrow

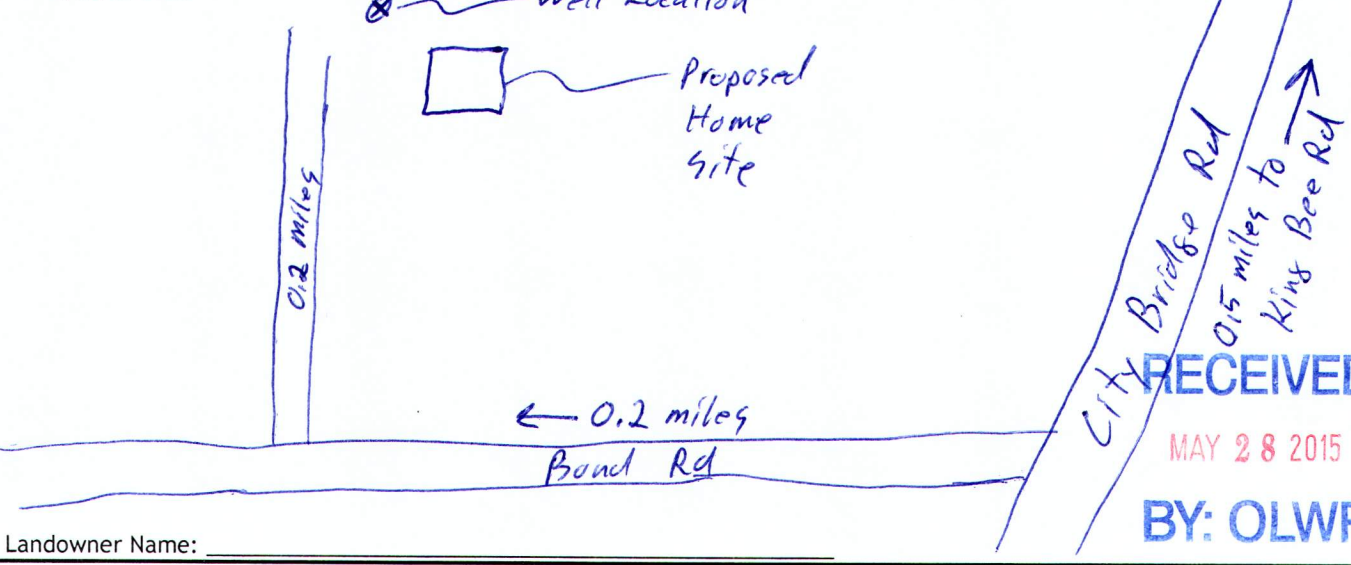

Landowner Name: \_\_\_\_\_

I HEREBY CERTIFY that the well/borehole was drilled, constructed, and completed in accordance with all applicable requirements of the Mississippi Department of Environmental Quality and the Mississippi Department of Health Regulations, if applicable, and state laws.

Heath S. Williams 0-790 5/21/15 Heath S. Williams MAY 28 2015  
Print Name of Responsible Licensee and License No. Date Signature of Licensee



STATE WELL REPORT

Part 2

Pump Installer's Completion Report

Mississippi Department of Environmental Quality
Office of Land and Water Resources
P.O. Box 2309
Jackson, MS 39225-2309
(601)961-5210
(601) 360-0535 (fax)

For Office Use Only:

Well #: G129
Aquifer:

County: Stone
Permit #:
Driller: H. Williams
Date completed: 5/20
Copy information from block on Part 1

This part of the report must be completed by a licensed water well contractor or a licensed pump installer. A copy of Part 1 of the report must be attached and both parts filed with the Department at the above address within 30 days of well completion.

Well Owner Information: Casey Bond, 36 Bond Rd, Perkinston, MS 39573
Well Location: Latitude 30° 48' 28" N, Longitude 89° 3' 34.5" W, Method of Lat/Long: Conventional Survey, USGS quad NW 1/4 NE 1/4, Sec 11 T 3 S R 11 W, 5.75 Miles SE of Wiggins, MS

Pump Type (circle one): Jet
Submersible Turbine Air Lift Centrifugal Flowing Well Jet Piston Rotary Other (describe):
Date Pump Installed: 5/20 Rated Pump Capacity: 7 Gallons Per Minute
Is This Pump (circle one): New Repaired Replacement

Power Type (circle one): Electric
Electric Diesel Gasoline Natural Gas Tractor PTO Windmill Other (describe):
Horse Power Rating of Motor: 100 Setting Depth: 50 feet Number of Stages:

Pump Test Data for Non Flowing Well
Date Well Tested: 5/20/15 Duration of Pump Test (minimum 4 hours): 4 hours
Static Water Level (A): 25 Feet Below Land Surface Pumping Water Level (B): 35 Feet Below Land Surface
Drawdown [(B) - (A)]: 10 Feet Below Land Surface Test Pumping Rate: 7 Gallons Per Minute
Method of measurement (circle one): Steel tape Electric tape Air line Other (describe):

Pump Test Data for Flowing Well
Measured shut in head: feet. N/A
Well yielded GPM with a drawdown of feet after hours of pumping

Meter Installation
Meter Manufacturer: N/A Meter Serial Number:
Meter Model Number/Name: Type of Meter:
Totalizer Register Unit and Multiplier Factor (AF x .001, gal x 1000, etc):
Installation Date: Meter installed by:
Is This Meter (circle one): New Repaired Replacement
Important: By submitting the above information you are certifying that this meter was installed to manufacturer standards. For agricultural wells, a list of approved meters is on the MDEQ website.

I HEREBY CERTIFY that the above statements are true to the best of my knowledge.
Heath S. Williams 0-790 5/21/15
Print Name of Pump Installer and License No. (if applicable) Date Signature of Pump Installer