

MISS. BD. OF WATER

STONE
G 2000
10-27-75

MISSISSIPPI
BOARD OF WATER COMMISSIONERS
416 North State Street
Jackson, Mississippi 39201

WATER WELL DRILLERS LOG

10-27-75
date well completed

Pannell Anderson
firm name

Stone
county well located

LANDOWNER:
Hershel Rouse
(mailing address)

description of formations encountered	from	to
Top Soil	0	4
Red Clay	4	14
Coarse Sand	14	79

WELL LOCATION:
sec. 35 T 3 N R 11 E 135
6 miles SE of Perk
(distance) (direction) (nearest town)

WELL PURPOSE: HOME
(home, irrigation, municipal, industrial)

WELL COMPLETION DATA:

- (1) diameter (inches) 2"
- (2) total depth (feet) 79
- (3) static water level (feet) 39' below top of ground.
- (4) casing Plastic 74' (material) (depth)
- (size) if telescope see back.
- (5) screen 5" 74' (length) (depth to top)
- 2" Plastic (size) (material)
- (6) pump 1 1/2 10 (HP) (yield gpm)
- Elect (type power)
- (7) electric log no (yes or no)

(organization running log)

(8) how well bottom plugged
Plugged


DRILLERS REMARKS:

DRILLING LOG
NOV 5 1975

MISS. BD. OF WATER

If well telescopes please sketch and show depths.

GROUND LEVEL

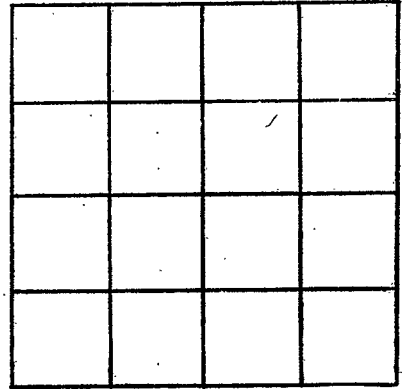

SECTION _____

Please indicate well location X.

ADDITIONAL INFORMATION

If more than one screen, show locations of each on sketch.