

Stone  
 G 2001  
 11-13-75

MISSISSIPPI  
 BOARD OF WATER COMMISSIONERS  
 416 North State Street  
 Jackson, Mississippi 39201

WATER WELL DRILLERS LOG

11-13 date well completed 1975 firm name Stone county well located

LANDOWNER:  
 Douglas Breland  
 (mailing address)

description of formations encountered	from		to
	feet	feet	
Top Soil	0	2	2
Clay	4	18	18
Coarse Sand	18	22	22
1 1/2 in Clay	22	120	120
Coarse Sand	120	145	145

WELL LOCATION:  
 sec. 19 T. 3 N. R. 21 W. 13Q  
 1 miles S of Perk  
 (distance) (direction) (nearest town)

WELL PURPOSE: HOME  
 (home, irrigation, municipal, industrial)

WELL COMPLETION DATA:

(1) diameter (inches) 14 5/8  
 (2) total depth (feet) 145  
 (3) static water level (feet) 76' below top of ground  
 (4) casing Plastic, 140' (material) (depth)  
 (size) If telescope see back.  
 (5) screen 5' 140' (length) (depth to top)  
 2" Plastic (size) (material)  
 (6) pump 1 8 (HP) (yield gpm)  
 Elect (type power)  
 (7) electric log no (yes or no)

(organization running log)

(8) how well bottom plugged Backwash valve


DRILLERS REMARKS:



DEC 4 1975

If well telescopes please sketch and show depths.

GROUND LEVEL

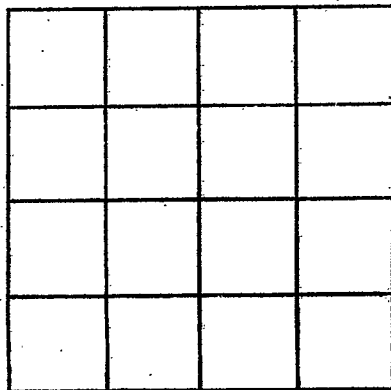

SECTION \_\_\_\_\_

Please indicate well location X.

ADDITIONAL INFORMATION

If more than one screen, show locations of each on sketch.