

Stone  
 G 2005  
 7-12-76

MISSISSIPPI  
 BOARD OF WATER COMMISSIONERS  
 416 North State Street  
 Jackson, Mississippi 39201

WATER WELL DRILLERS LOG

7-12 date well completed 1976 firm name Stone county well located

LANDOWNER:	description of formations encountered	from	to
Gladis Holzer (mailing address)	Top Soil	0	5
	Sandy Clay	3	35
	Flint Sand	35	39
	Coarse Sand	39	42

WELL LOCATION:  
 sec. 33 T. 3 R. 11 E.  
 3 miles S E of Perk  
 (distance) (direction) (nearest town)

WELL PURPOSE: HOME  
 (home, irrigation, municipal, industrial)

WELL COMPLETION DATA:  
 (1) diameter (inches) 2"  
 (2) total depth (feet) 42'  
 (3) static water level (feet) 38' below top of ground.  
 (4) casing Plastic 4.3' (material) (depth)  
 (size) if telescope see back.  
 (5) screen 5' 4.3' (length) (depth to top)  
 2" Plastic (size) (material)  
 (6) pump 1 (HP) 65 (yield gpm)  
 Elect (type power)  
 (7) electric log No (yes or no)  
 (organization running log)  
 (8) how well bottom plugged Backwash valve


DRILLERS REMARKS:

RECEIVED  
 AUG 6 - 1976

MISS. BD. OF WATER COMMISSIONERS

If well telescopes please sketch and show depths.

GROUND LEVEL

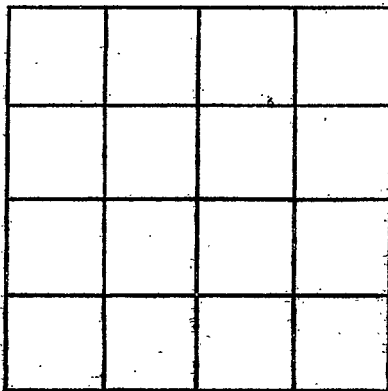

SECTION \_\_\_\_\_

Please indicate well location X.

ADDITIONAL INFORMATION

If more than one screen, show locations of each on sketch.