

Stone
G2000
9-13-76

MISSISSIPPI
BOARD OF WATER COMMISSIONERS
416 North State Street
Jackson, Mississippi 39201

WATER WELL DRILLERS LOG

9-13 1976 Donnell Anderson Stone
date well completed firm name county well located


LANDOWNER:	description of formations encountered	from	to
<u>Don Bond</u>			
(mailing address)	<u>Red Clay</u>	<u>4</u>	<u>38</u>
WELL LOCATION:	<u>Course Sand</u>	<u>38</u>	<u>60</u>
sec. <u>2</u> T. <u>3</u> S. R. <u>11</u> W.			
<u>5</u> miles <u>SE</u> of <u>Wiggins</u>			
(distance) (direction) (nearest town)			
WELL PURPOSE: <u>HOME</u>			
(home, irrigation, municipal, industrial)			
WELL COMPLETION DATA:			
(1) diameter (inches) <u>2"</u>			
(2) total depth (feet) <u>60'</u>			
(3) static water level (feet) <u>23'</u> below top of ground.			
(4) casing (material) <u>Plastic</u> , (depth) <u>55'</u>			
(size) If telescope see back.			
(5) screen <u>5'</u> (length), <u>5-5'</u> (depth to top)			
<u>2"</u> (size), <u>Plastic</u> (material)			
(6) pump <u>1</u> (HP), <u>10</u> (yield gpm)			
<u>E. Peet</u> (type power)			
(7) electric log <u>no</u> (yes or no)			
(organization running log)			
(8) how well bottom plugged <u>Capped</u>			
DRILLERS REMARKS:			

RECEIVED
OCT - 8 1976

MISS. BD. OF WATER COMMISSIONERS

If well telescopes please sketch and show depths.

GROUND LEVEL

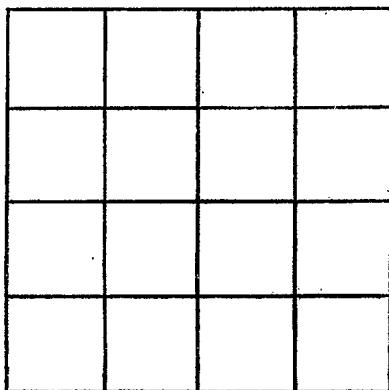

SECTION _____

Please indicate well location X.

ADDITIONAL INFORMATION

If more than one screen, show locations of each on sketch.