

Stone
G 2007
10-11-76

MISSISSIPPI
 BOARD OF WATER COMMISSIONERS
 416 North State Street
 Jackson, Mississippi 39201

13a

WATER WELL DRILLERS LOG

10-11-76 date well completed Stone firm name Stone county well located


LANDOWNER:	description of formations encountered	from	to
<u>Homer J. Rainwater</u>			
(mailing address)	<u>Blue Clay</u>	<u>4</u>	<u>82</u>
WELL LOCATION:	<u>Fine Sand</u>	<u>82</u>	<u>91</u>
sec. <u>19</u> T. <u>3</u> S. R. <u>11</u> W.	<u>Coarse Sand</u>	<u>91</u>	<u>105</u>
<u>1</u> miles <u>S</u> of <u>Deer</u>			
(distance) (direction) (nearest town)			
WELL PURPOSE: <u>HOME</u>			
(home, irrigation, municipal, industrial)			
WELL COMPLETION DATA:			
(1) diameter (inches) <u>2"</u>			
(2) total depth (feet) <u>105'</u>			
(3) static water level (feet) <u>13'</u> below top of ground.			
(4) casing <u>Plastic 200'</u>			
(material) (depth)			
(size) if telescope see back.			
(5) screen <u>5' 200'</u>			
(length) (depth to top)			
<u>2" Plastic</u>			
(size) (material)			
(6) pump <u>1</u> <u>10</u>			
(HP) (yield gpm)			
<u>Elect</u>			
(type power)			
(7) electric log <u>no</u>			
(yes or no)			
(organization running log)			
(8) how well bottom plugged <u>Capped</u>			
DRILLERS REMARKS:			

RECEIVED
 NOV - 4 1976

MISS. BD. OF WATER COMM.

If well telescopes please sketch and show depths.

GROUND LEVEL

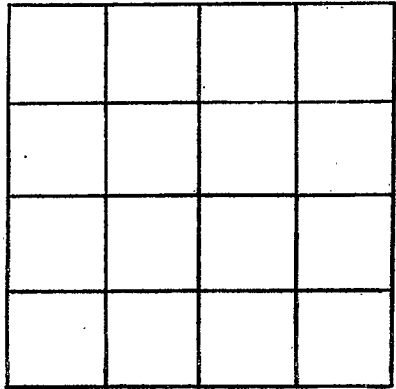

SECTION _____

Please indicate well location X.

ADDITIONAL INFORMATION

If more than one screen,
show locations of each on sketch.